1 2 3 4 1

P L A C E

12341

Sub Doc Type

B L

Number LG Docs

0 0 1 5

Box Number

Street #

1 3 7 1

Street Dir

Doc Type

P L

Street Name

K O O S E R

Street Type

R D

Tract Number

Document Date

1 1 / 3 0 / 7 8

	Prepped By	**Scanned By**	**Indexed By**	**Verified By**
Initials	RT			
Date	06/06			

SYM	ECO NO.	REVISIONS DESCRIPTION	DATE	APPROVED
△		ZONING DEPT REVISIONS	3-2-79	

SAN JOSE
PLANNING
SUBJECT TO CONDITIONS

B. Pleau 3/5/79
Paint to match rest of center.

12341

12841

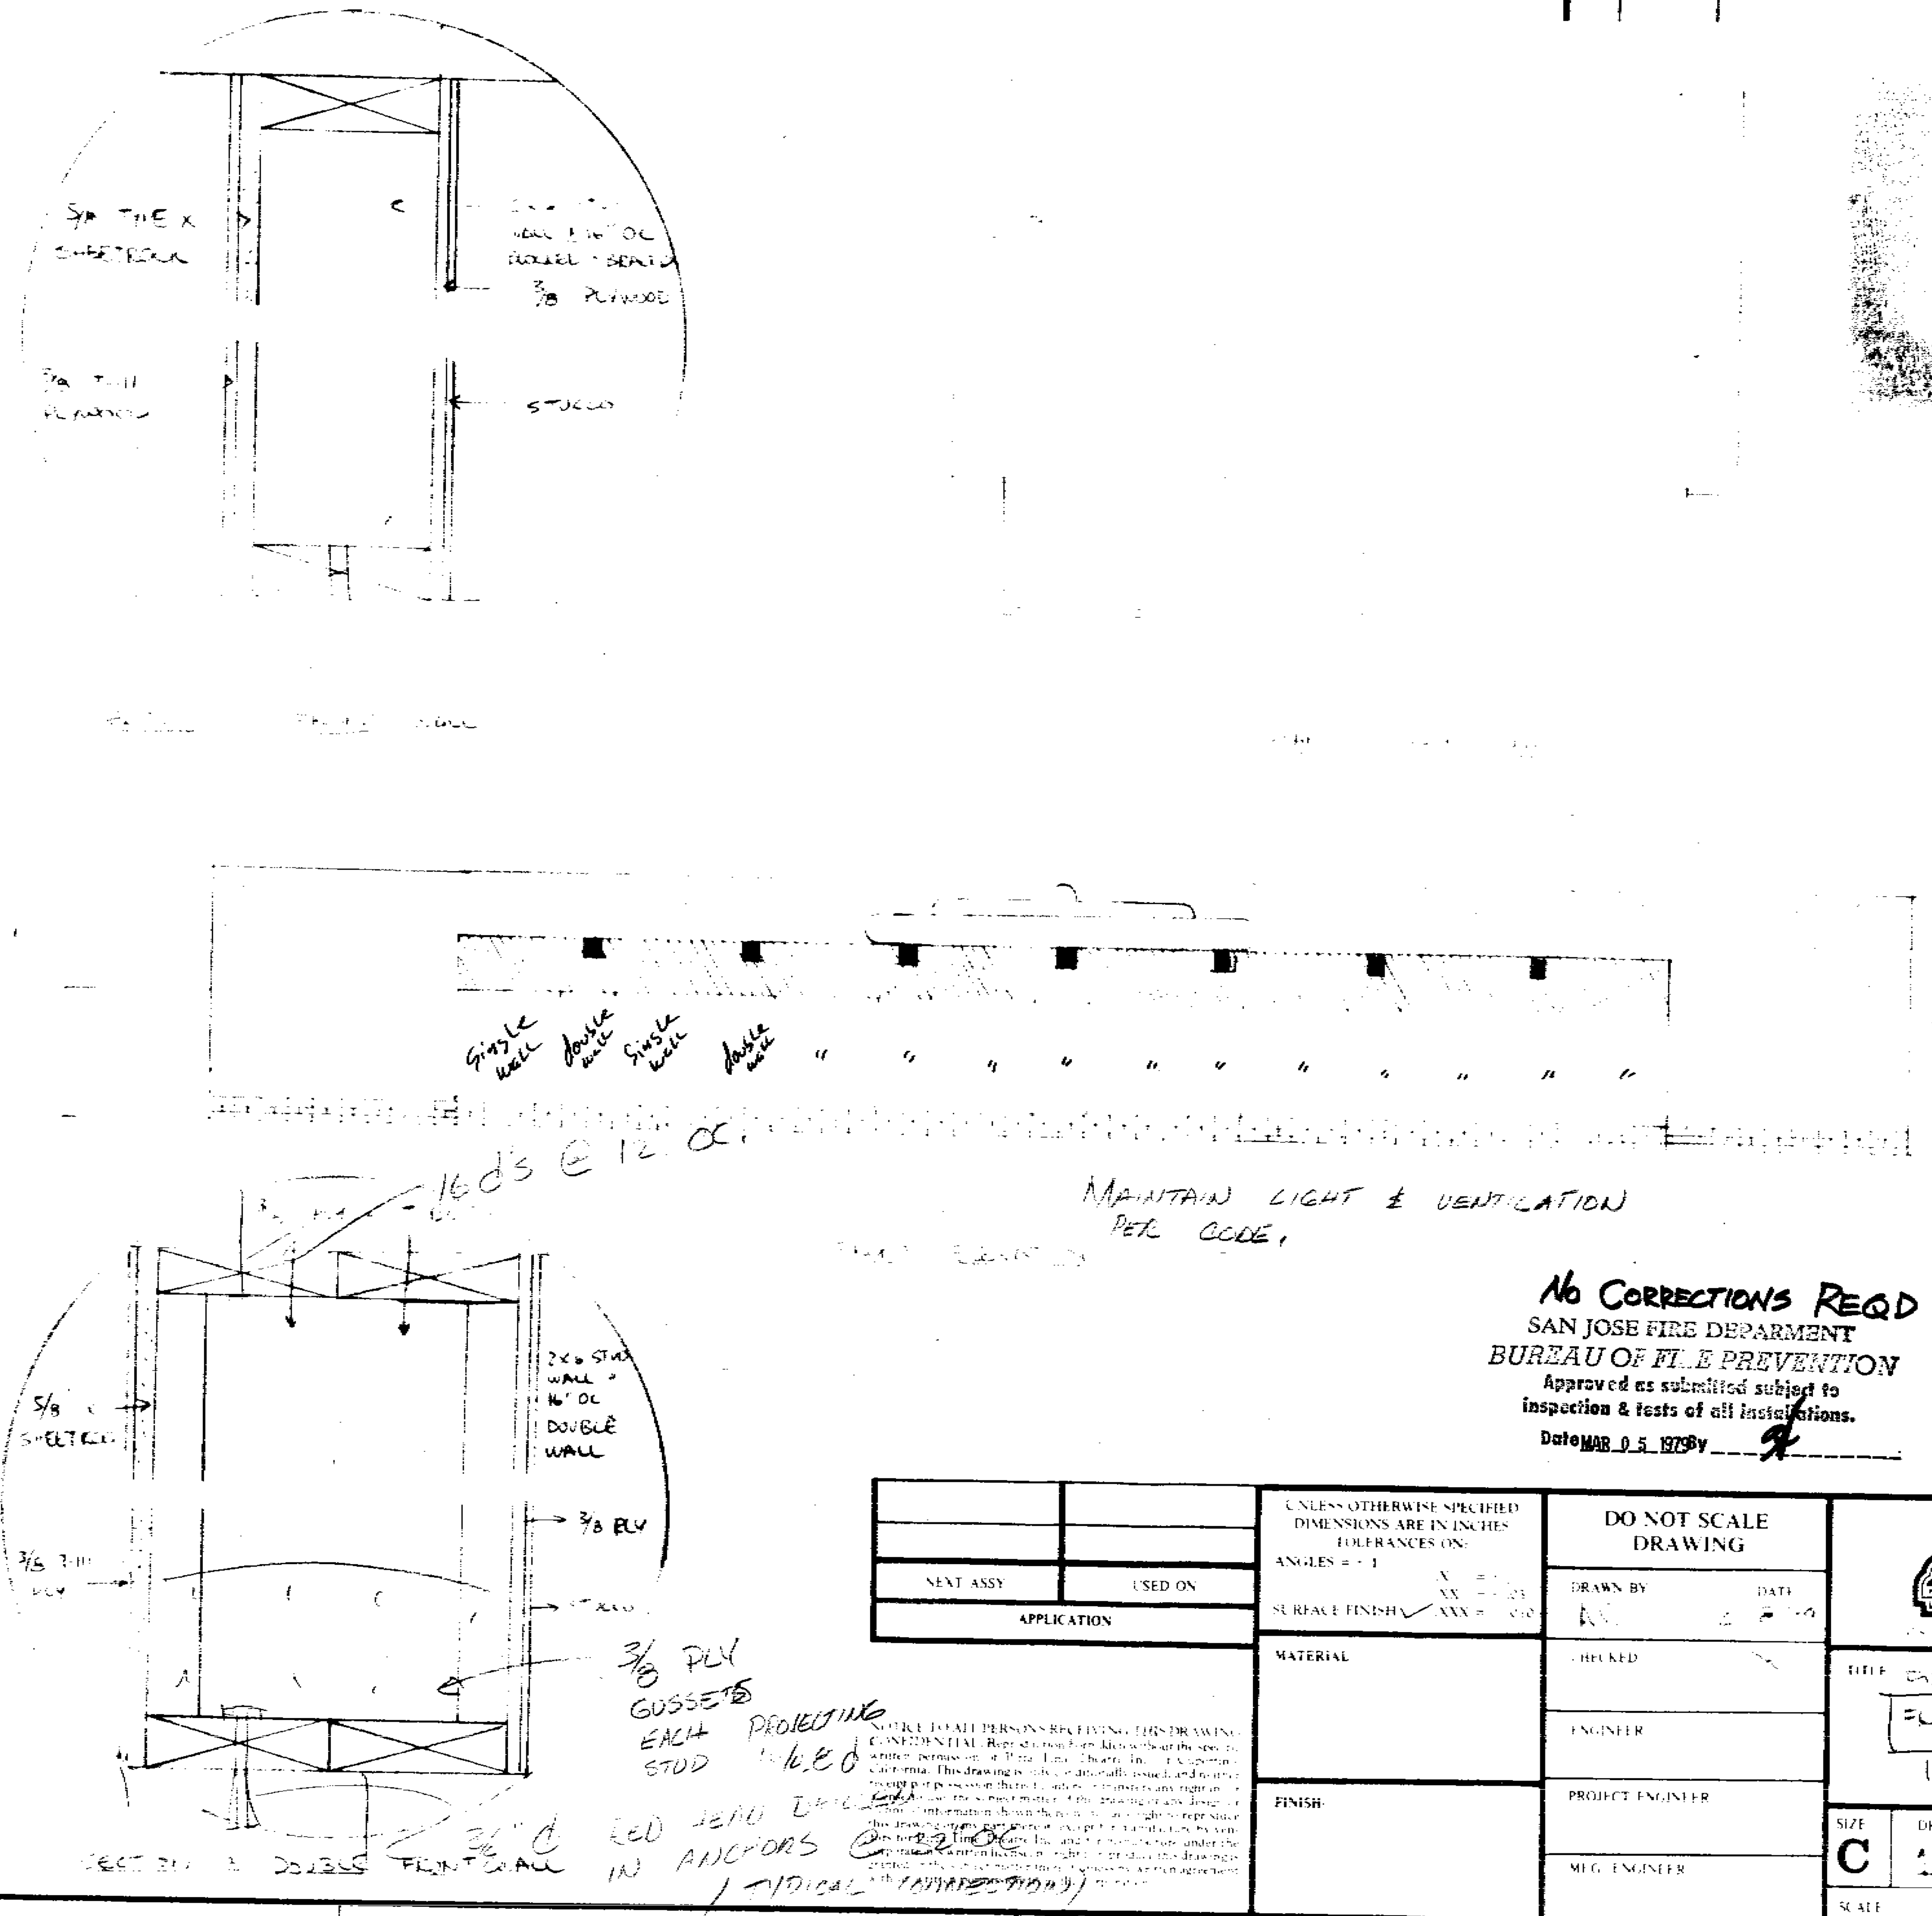

MAINTAIN LIGHT & VENTILATION PER CODE.

3/4" ∅ LED HEAD DRILLED IN ANCHORS @ 32" OC (TYPICAL CONNECTION)

MAR 02 1979

No CORRECTIONS REQD
SAN JOSE FIRE DEPARMENT
BUREAU OF FIRE PREVENTION
Approved as submitted subject to inspection & tests of all installations.
Date MAR 0 5 1979 By

OUTSTANDING ECNs	

C-1
A-3
8,733
94
yes

NEXT ASSY	USED ON
APPLICATION	

NOTICE TO ALL PERSONS RECEIVING THIS DRAWING: CONFIDENTIAL. [illegible] Pizza Time Theatre Inc. [illegible]

UNLESS OTHERWISE SPECIFIED DIMENSIONS ARE IN INCHES TOLERANCES ON:
ANGLES = ± 1
.X = ±
.XX = ± .03
SURFACE FINISH ✓ .XXX = ± .010

MATERIAL

FINISH

DO NOT SCALE DRAWING

DRAWN BY: KC DATE: 2-7-79
CHECKED
ENGINEER
PROJECT ENGINEER
MFG. ENGINEER

Pizza Time Theatre Inc.
10060 Bubb Road
Cupertino, CA 95014

TITLE: PIZZA TIME THEATRE CENTER, FRONT WALL SECTION
WEST
1371 KOOSER RD.

SIZE: C
DRAWING NO.: 4
SCALE
SHEET

TO FPB
13672

reg'd for "games". [illegible]
does not constitute [illegible]
entertainment which [illegible]
permitted in C-1 [illegible]
Per F.A.B. 7/31/73 [illegible]

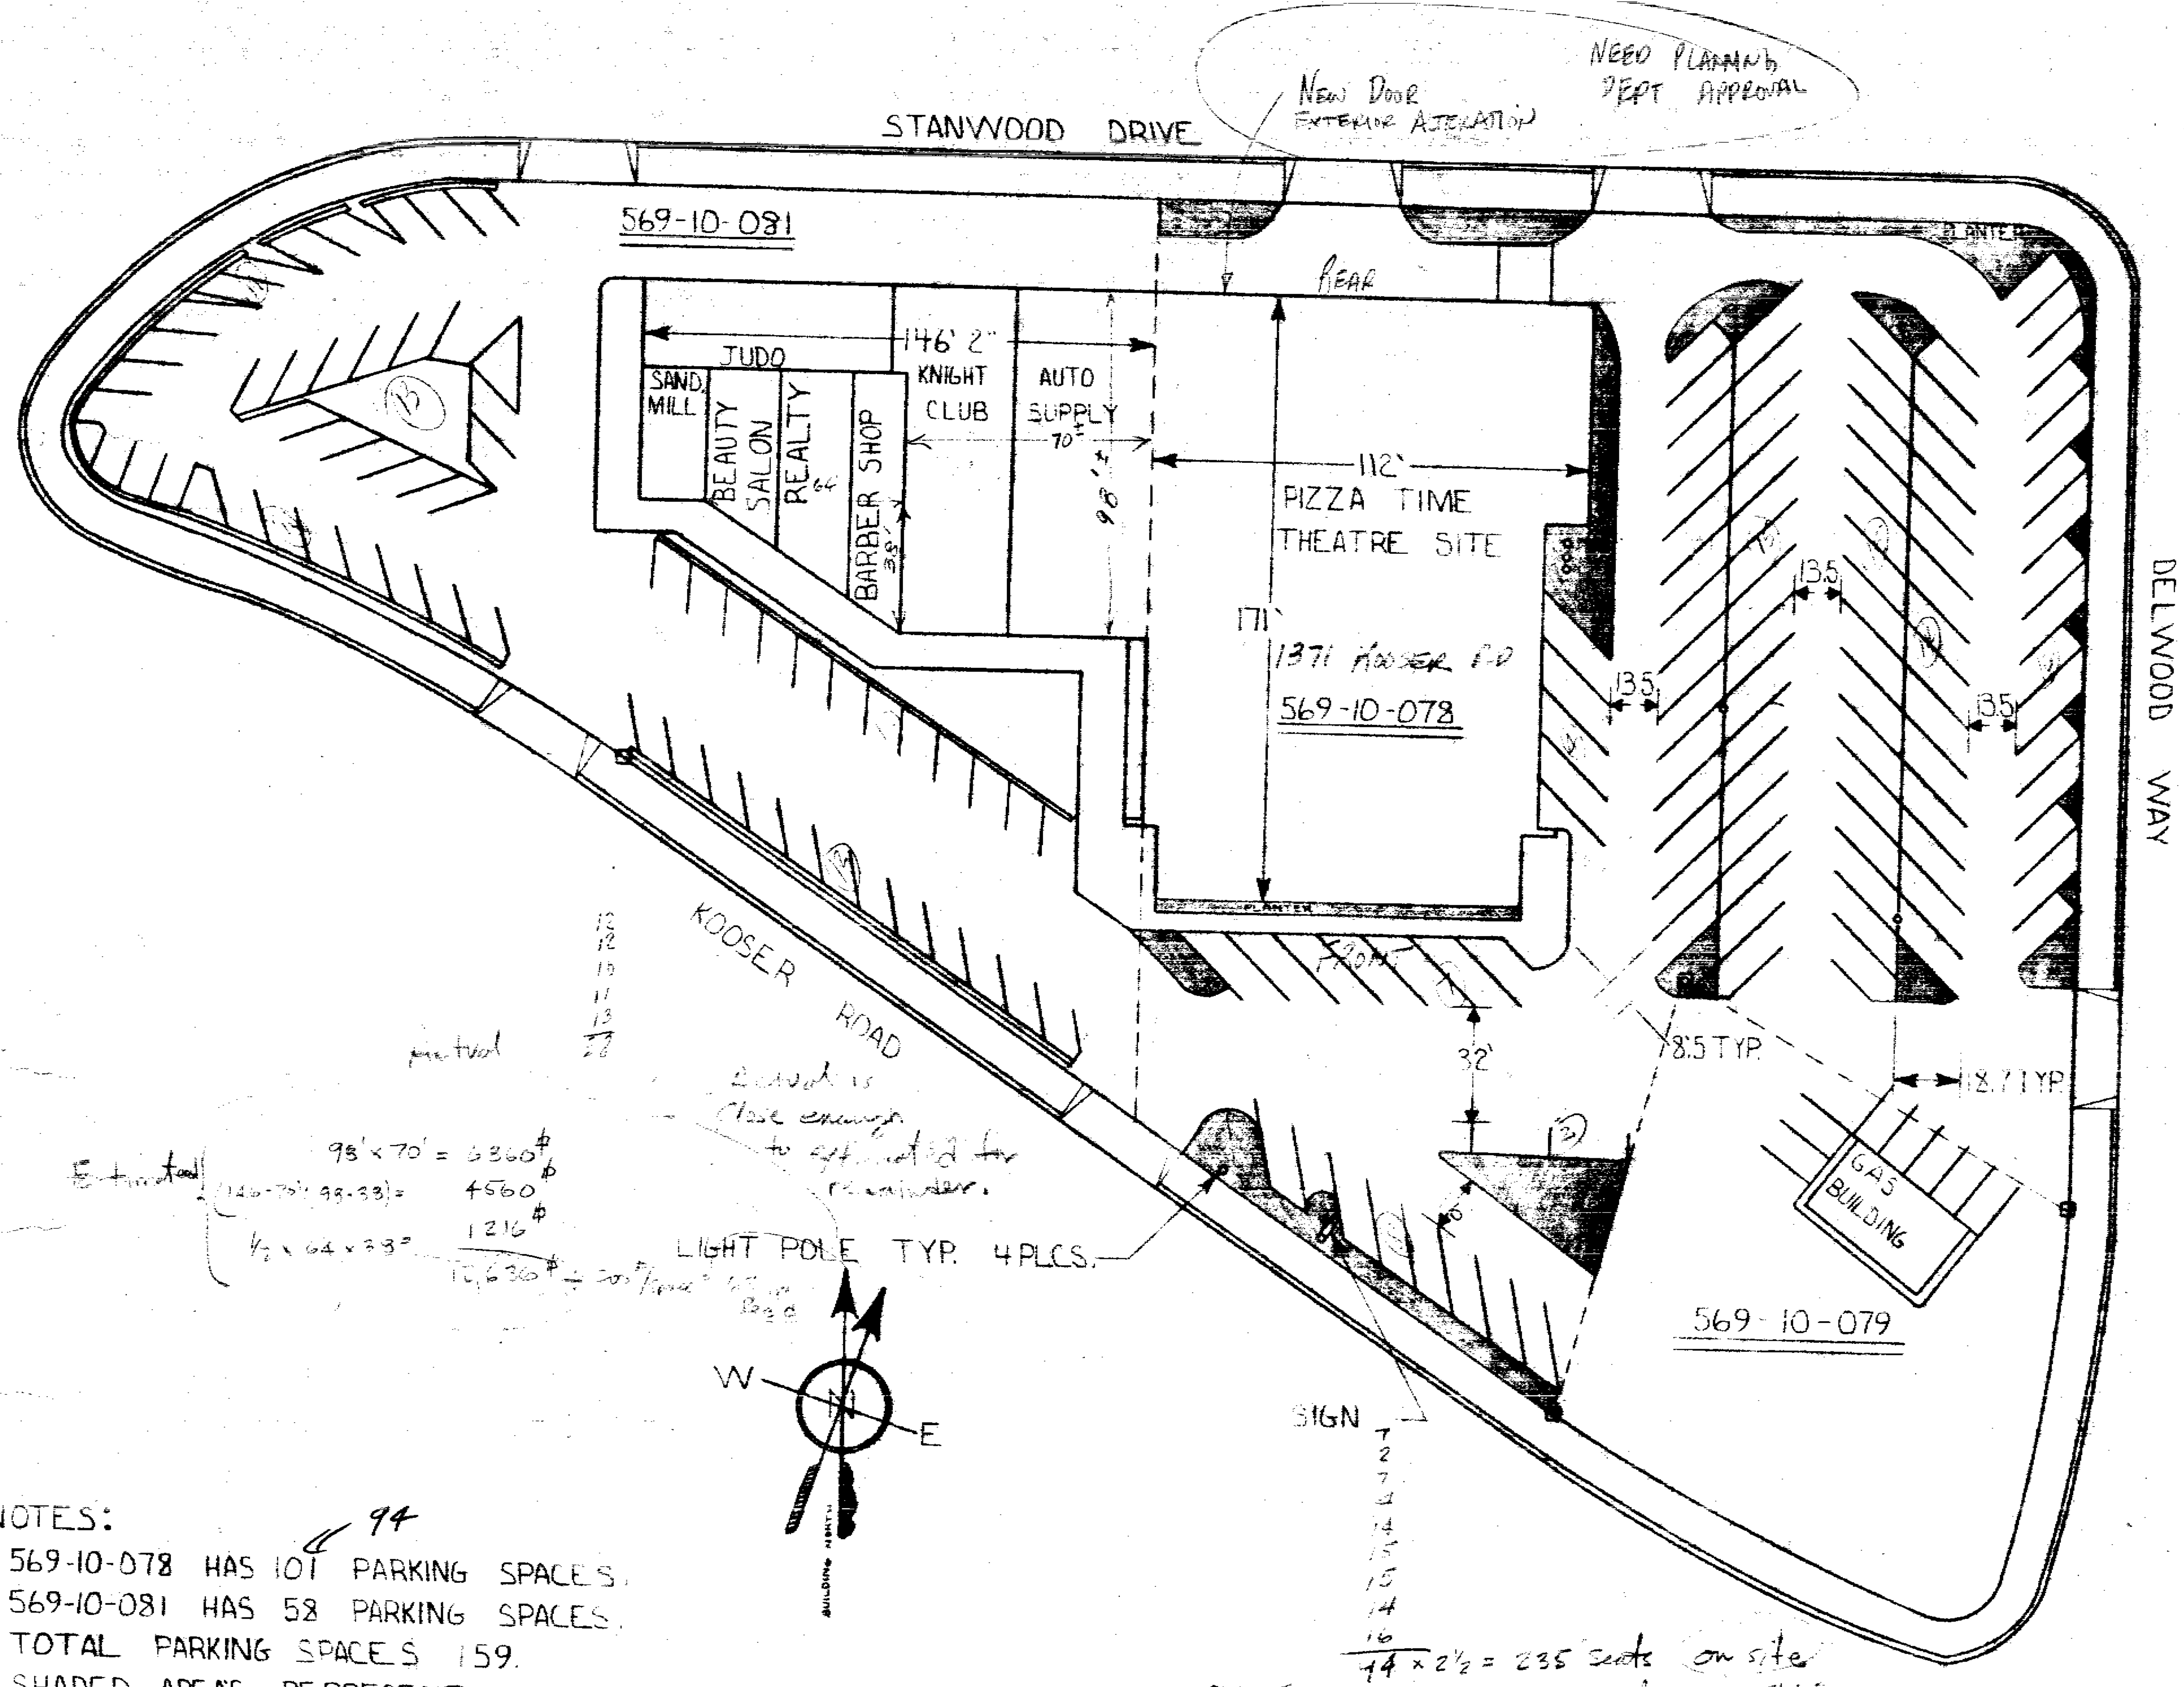

Actual
12
12
10
11
13
22

Actual is close enough to estimated for remainder.

Estimated
98' × 70' = 6860 ☐
(146-70) × 98-38) = 4560 ☐
½ × 64 × 38 = 1216 ☐
10,636 ☐ ÷ 200 ☐/space = [illegible]
Req'd

1
2
7
9
14
15
15
14
16
94 × 2½ = 235 seats on site
OFF SITE → 7 × 2½ = 17 seats Gas Station
252

Need Planning Commission Approval for off site parking

NOTES:
1. 569-10-078 HAS ~~101~~ 94 PARKING SPACES.
2. 569-10-081 HAS 58 PARKING SPACES.
3. TOTAL PARKING SPACES 159.
4. SHADED AREAS REPRESENT PLANTERS.

104 × 2.5 = 260

P/c 147.23 $100,000

Permit 287.00
SMIPA 7.00
BBS@1½ 1500.00
$1794.00

No ERMP
Submitted 7/17
Made additional P/c 12357X for @ $5000.00 ($20.00) for change △2

1 Story Metal
Type V-N
B-3 Occupancy
C-1 zone
Fire Zone 2
13,733 ☐±

#12341 ✓

12341

Formerly [illegible]

OUTSTANDING ECNs	
# PECK'S [illegible]	[illegible]

NEXT ASSY	USED ON
APPLICATION	

NOTICE TO ALL PERSONS RECEIVING THIS DRAWING
CONFIDENTIAL: Reproduction Forbidden without the specific written permission of Pizza Time Theatre Inc., Mountain View, California. This drawing is only conditionally issued, and neither receipt nor possession thereof confers or transfers any right in, or license to use, the subject matter of the drawing or any design or technical information shown thereon, nor any right to reproduce this drawing or any part thereof, except for manufacture by vendors for Pizza Time Theatre Inc. and for manufacture under the corporation's written license, no right to reproduce this drawing is granted or the subject matter thereof unless by written agreement with or written permission from the corporation.

UNLESS OTHERWISE SPECIFIED DIMENSIONS ARE IN INCHES TOLERANCES ON:
ANGLES = ±1°
.x = ±.1
.xx = ±.03
.xxx = ±.005
SURFACE FINISH ✓
MATERIAL:
FINISH:

DO NOT SCALE DRAWING
DRAWN BY Bradley C. Root DATE 7-7-79
CHECKED
ENGINEER
PROJECT ENGINEER
MFG. ENGINEER

Pizza Time Theatre Inc.
455 N. Bernardo Avenue
Suite A
Mountain View, CA 94043

© 1978 Pizza Time Theatre Inc.

TITLE 1371 KOOSER RD
PARKING LOT
KOOSER SITE

2

SIZE D
DRAWING NO BLDG DEPT COPY
REV
SCALE 1/32" = 1'
SHEET 1 OF

15340

12341

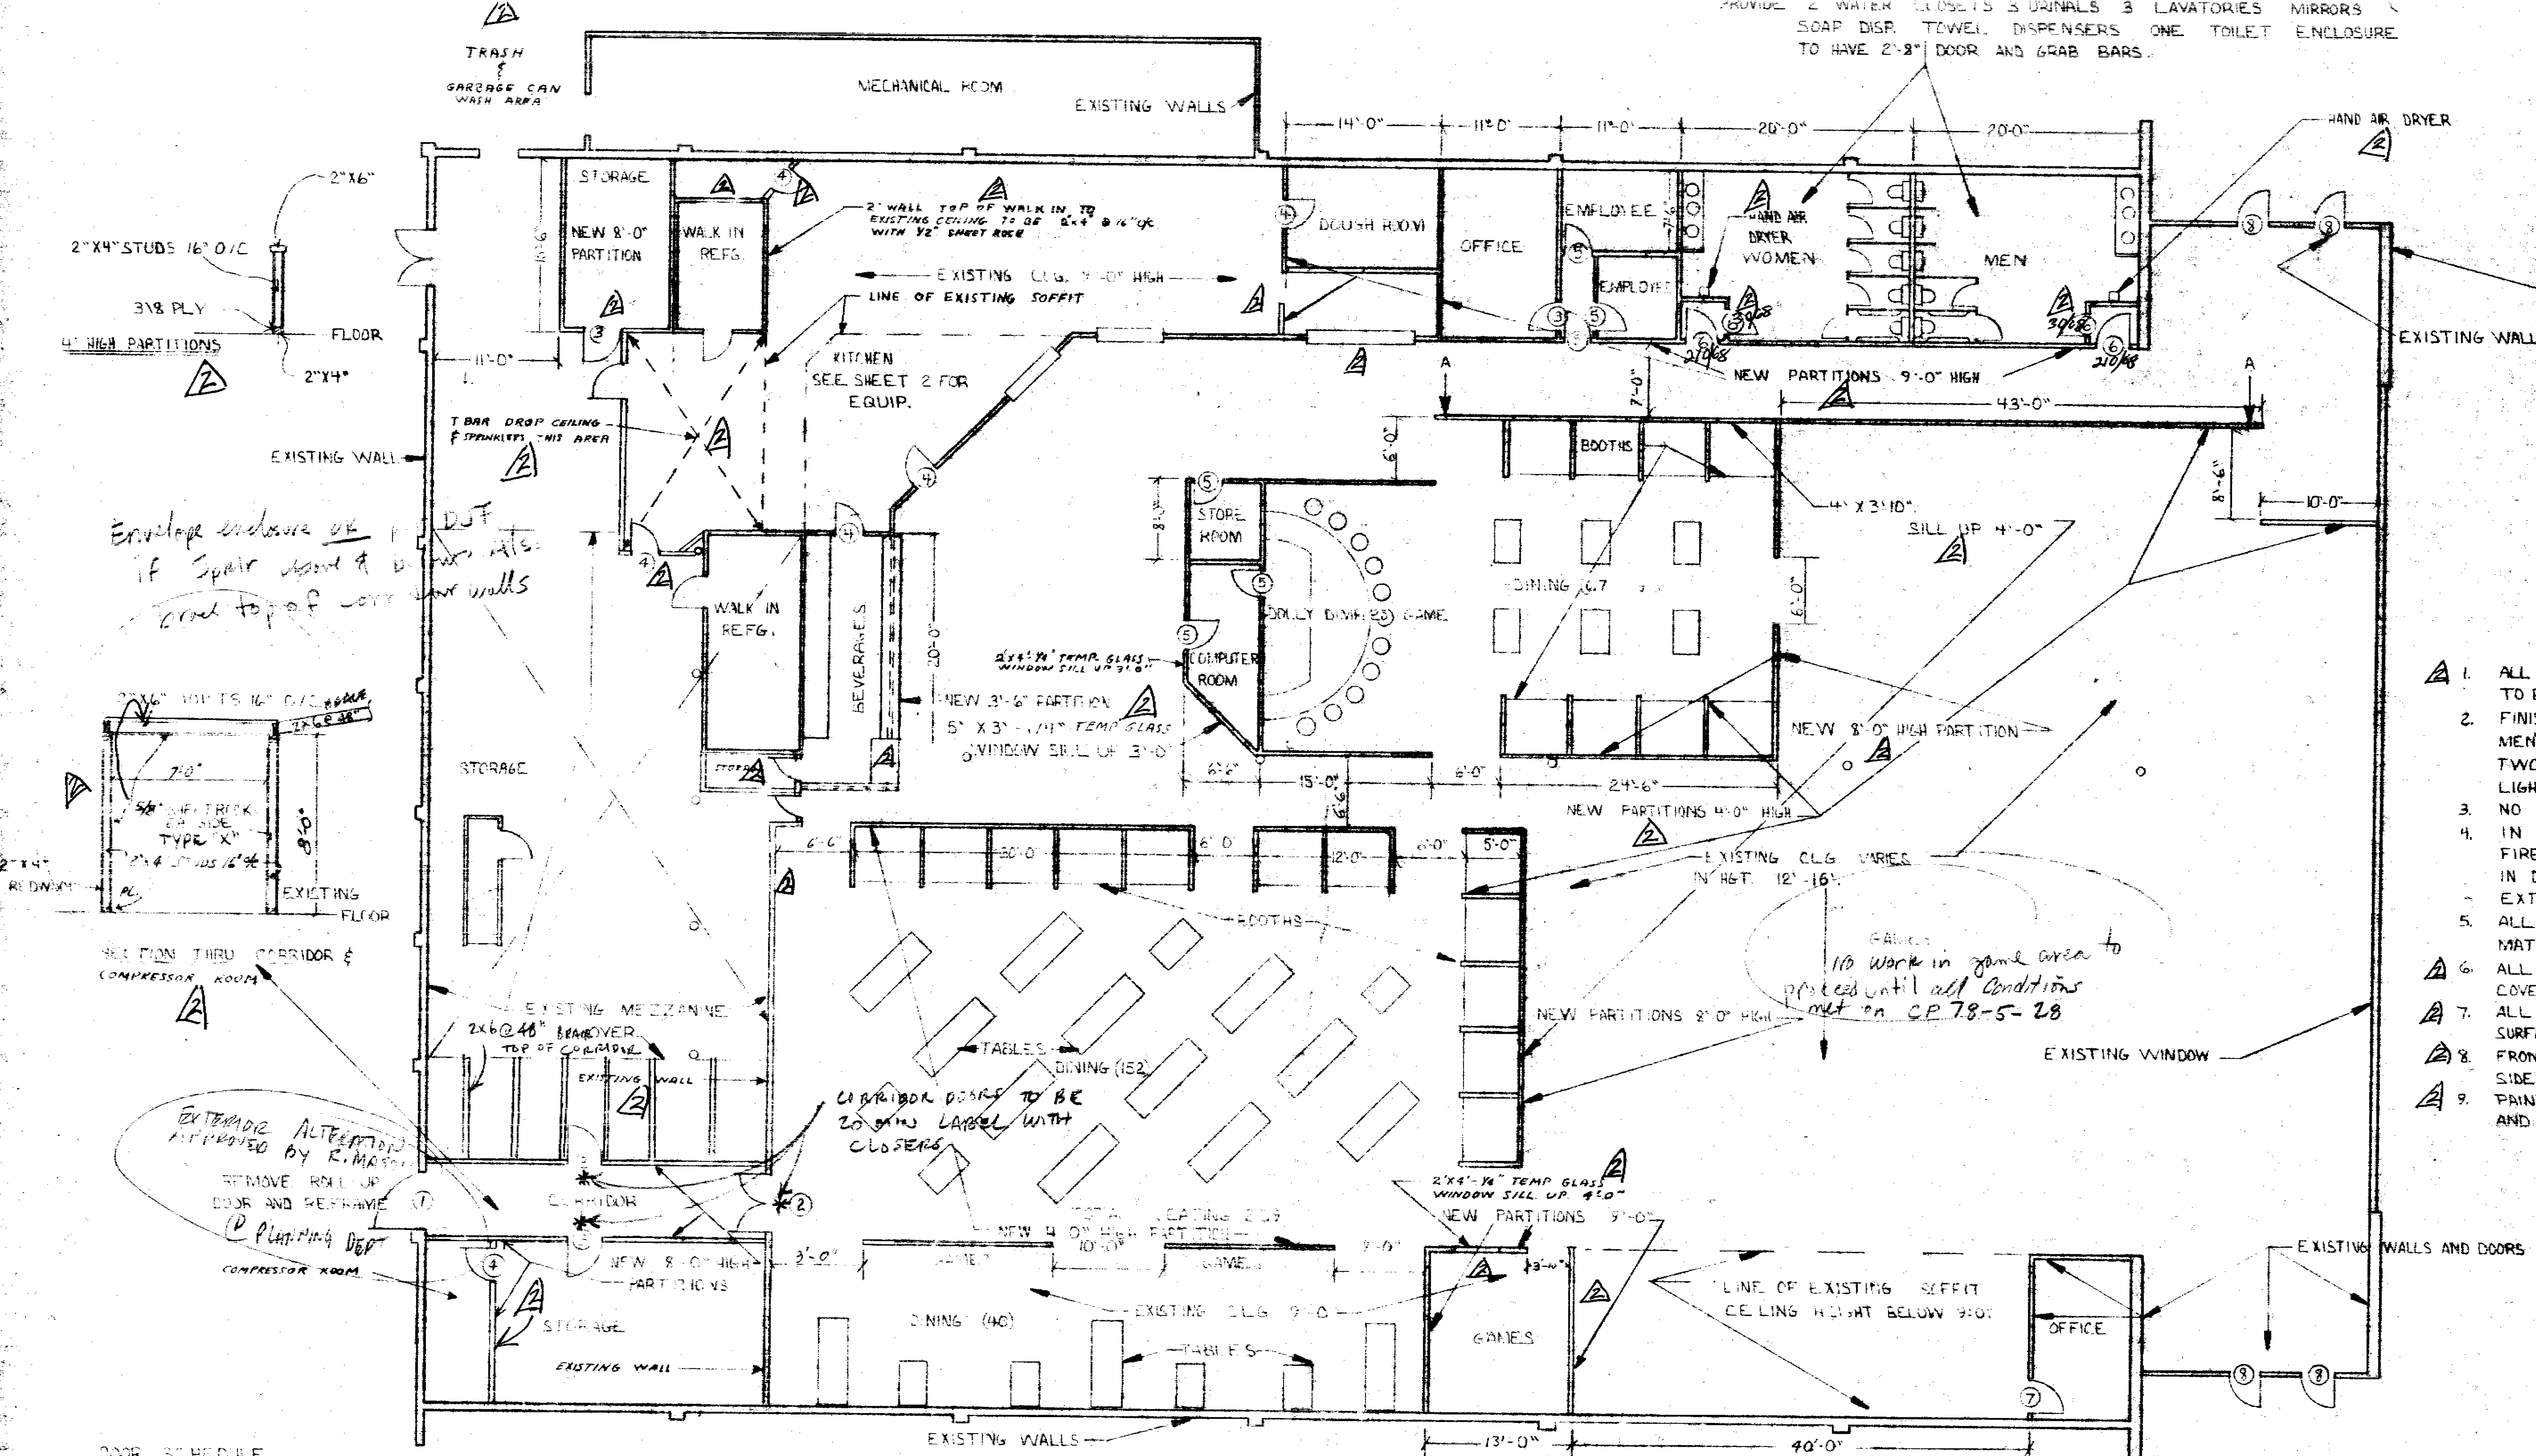
PROVIDE 2 WATER CLOSETS 3 URINALS 3 LAVATORIES MIRRORS SOAP DISP. TOWEL DISPENSERS ONE TOILET ENCLOSURE TO HAVE 2'-8" DOOR AND GRAB BARS.
TRASH & GARBAGE CAN WASH AREA
MECHANICAL ROOM
EXISTING WALLS
2"X6"
2"X4" STUDS 16" O/C
3/8 PLY
FLOOR
2"X4"
4' HIGH PARTITIONS
STORAGE
NEW 8'-0" PARTITION
WALK IN REFG.
2" WALL TOP OF WALK IN TO EXISTING CEILING TO BE 2x4 @ 16" o/c WITH 1/2" SHEET ROCK
EXISTING CLG. 9'-0" HIGH
LINE OF EXISTING SOFFIT
KITCHEN SEE SHEET 2 FOR EQUIP.
T BAR DROP CEILING & SPRINKLERS THIS AREA
EXISTING WALL
11'-0"
Envelope enclosure OK DJT
if Sprlr [illegible] Als.
[illegible] top of [illegible] walls
WALK IN REFG.
BEVERAGES
20'-0"
2'x4'-1/4" TEMP. GLASS WINDOW SILL UP 3'-0"
NEW 3'-6" PARTITION
5' X 3' - 1/4" TEMP GLASS WINDOW SILL UP 3'-0"
STORE ROOM
COMPUTER ROOM
DOLLY DIMPLES GAME
DOUGH ROOM
OFFICE
EMPLOYEE
EMPLOYEE
HAND AIR DRYER
WOMEN
MEN
HAND AIR DRYER
14'-0"
11'-0"
11'-0"
20'-0"
20'-0"
3068
2068
3068
2068
NEW PARTITIONS 9'-0" HIGH
43'-0"
A
A
EXISTING WALLS AND DOORS
BOOTHS
4' X 3'10"
SILL UP 4'-0"
DINING (67)
6'-0"
8'-6"
10'-0"
NEW 8'-0" HIGH PARTITION
6'-6"
15'-0"
6'-0"
24'-6"
NEW PARTITIONS 4'-0" HIGH
EXISTING CLG VARIES IN HGT. 12'-16'
5'-0"
12'-0"
30'-0"
6'-0"
BOOTHS
GAMES
No work in game area to proceed until all Conditions met on CP 78-5-28
NEW PARTITIONS 8'-0" HIGH
EXISTING WINDOW
2"x6" JOISTS 16" O/C
2x6 @ 48"
7'-0"
5/8" SHEETROCK EA SIDE TYPE "X"
2x4 STUDS 16" o/c
8'-0"
2"x4" REDWOOD
PL.
EXISTING FLOOR
SECTION THRU CORRIDOR & COMPRESSOR ROOM
STORAGE
EXISTING MEZZANINE
2x6 @ 48" BRACE OVER TOP OF CORRIDOR
EXISTING WALL
TABLES
DINING (152)
CORRIDOR DOORS TO BE 20 MIN LABEL WITH CLOSERS
EXTERIOR ALTERATION APPROVED BY R. MASON
REMOVE ROLL UP DOOR AND REFRAME
@ Planning Dept
CORRIDOR
COMPRESSOR ROOM
NEW 8'-0" HIGH PARTITIONS
STORAGE
EXISTING WALL
3'-0"
TOTAL SEATING 259
NEW 4'-0" HIGH PARTITION
10'-0"
GAMES
GAMES
9'-0"
EXISTING CLG 9'-0"
DINING (40)
TABLES
2'X4'-1/4" TEMP GLASS WINDOW SILL UP 4'-0"
NEW PARTITIONS 9'-0"
3'-0"
GAMES
LINE OF EXISTING SOFFIT CEILING HEIGHT BELOW 9'-0"
OFFICE
EXISTING WALLS AND DOORS
EXISTING WALLS
13'-0"
40'-0"

NOTES

1. ALL NEW 8' PARTITIONS FLOOR TO CEILING TO BE 2"X4" @ 16" O/C WITH 1/2 SHEET ROCK BOTH SIDES
2. FINISH OF KITCHEN, DOUGH ROOM, STORAGE, MEN'S AND WOMEN'S TOILETS TO BE TWO (2) COATS SEMI-GLOSS ENAMEL LIGHT COLOR.
3. NO STRUCTURAL CHANGES ARE TO BE MADE
4. IN KITCHEN PROVIDE (2) 20-B-C FIRE EXTINGUSHERS.
IN DINING PROVIDE (2) 2-A-10B-C FIRE EXTINGUSHERS.
5. ALL WOOD PANELING OR DECORATIVE MATERIALS SHALL BE FLAME TREATED.
6. ALL INTERIOR FREE STANDING WALLS COVERED WITH 3/8 PLY ONLY.
7. ALL GLASS TO BE PAINTED ON INTERIOR SURFACE ONLY.
8. FRONT DOORS (8) TO BE COVERED ON BOTH SIDES WITH 3/8 PLY.
9. PAINT INTERIOR SURFACES FROM 8' UP TO AND INCLUDING CEILING WITH DARK PAINT (BLACK).

C-1 Zone
B-3 Occupancy 1973 UBC
1 STY + Mezz
TYPE III-N Sprk
Fire Zone 2
Permit # 12341V

1371 Kooser Rd

DOOR SCHEDULE

NO.	SIZE	TYPE	MISC.
1	4°-6°	SOLID CORE	PANIC HARDWARE CLOSER
2	3°-6⁸	HOL. CORE	"
3	3°-6⁸	SOLID CORE	DEAD BOLT LOCK
4	3°-6⁸	HOL. CORE	NO LOCK CLOSER
5	3°-6⁸	HOL. CORE	DEAD BOLT LOCK
6	2°-6⁸	HOL. CORE	CLOSER ← 32" min clr @ Bathrooms
7	EXISTING		ADD DEAD BOLT LOCK
8	"		ADD PANIC HARDWARE

ALL DOORS UNLISTED ARE EXISTING WITH NO CHANGES.

FLOOR PLAN
1/8 = 1'-0" SCALE

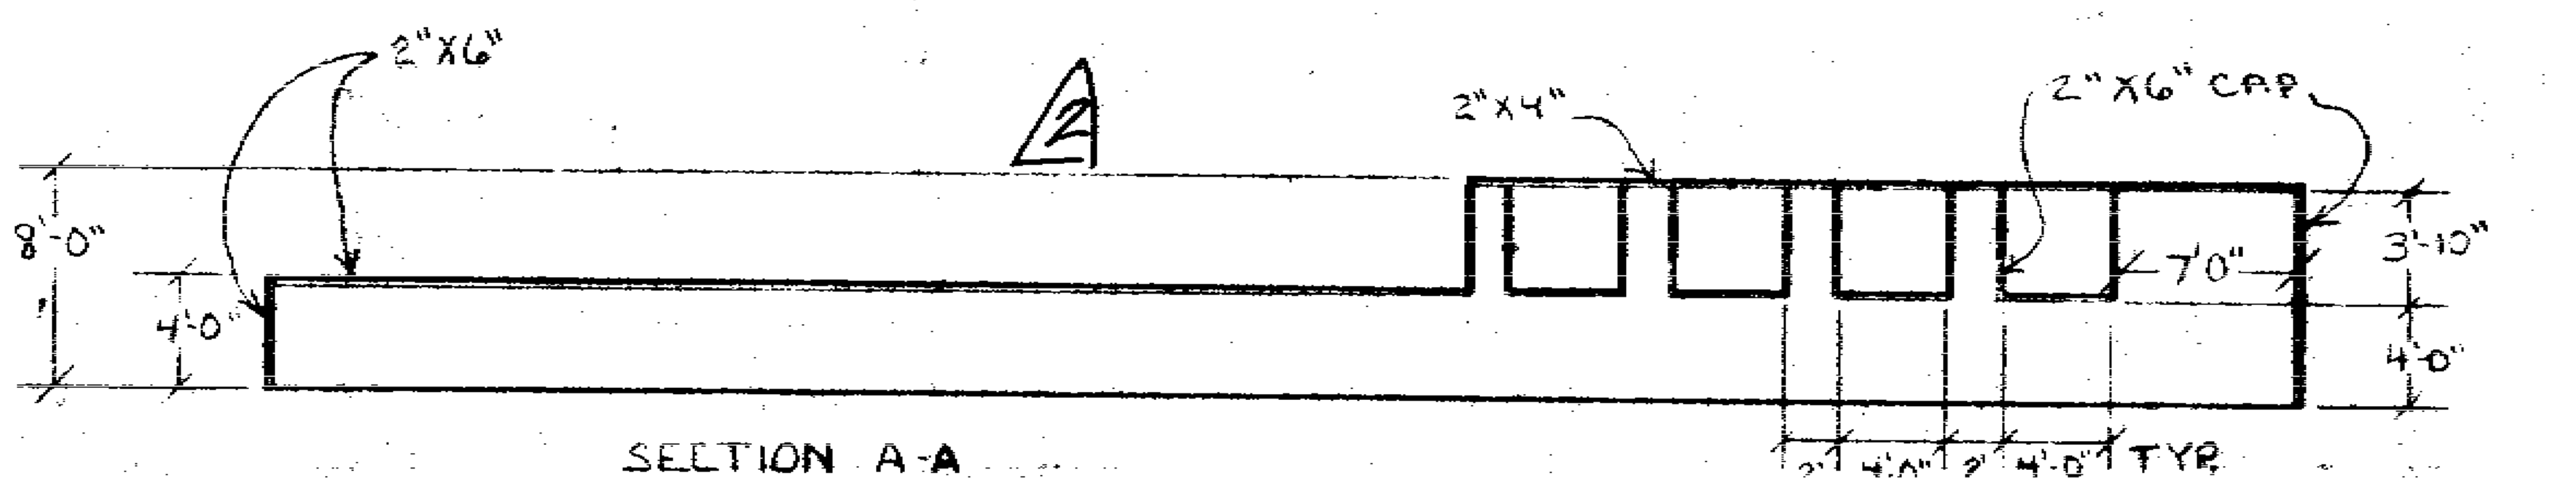

SECTION A-A
WINDOW FRAMING DETAIL

NOTICE TO ALL PERSONS RECEIVING THIS DRAWING
CONFIDENTIAL: Reproduction Forbidden without the specific written permission of Pizza Time Theatre Inc., Mountain View, California. This drawing is only conditionally issued, and neither receipt nor possession thereof confers or transfers any right in, or license to use, the subject matter of the drawing or any design or technical information shown thereon, nor any right to reproduce this drawing or any part thereof, except for manufacture by vendors for Pizza Time Theatre Inc. and for manufacture under the corporation's written license, no right to reproduce this drawing is granted or the subject matter thereof unless by written agreement with or written permission from the corporation.

Change 2
Permit # 12341 ✓

Pizza Time Theatre Inc.
455 N. Bernardo Avenue
Suite A
Mountain View, CA 94043

© 1978 Pizza Time Theatre Inc.

3

BY: DESIGN SERVICES
OF MENLO PARK CA.

REV C
10/25/78
~~REV. B~~

P/C 15840 P/C 15840 Revised SHEET

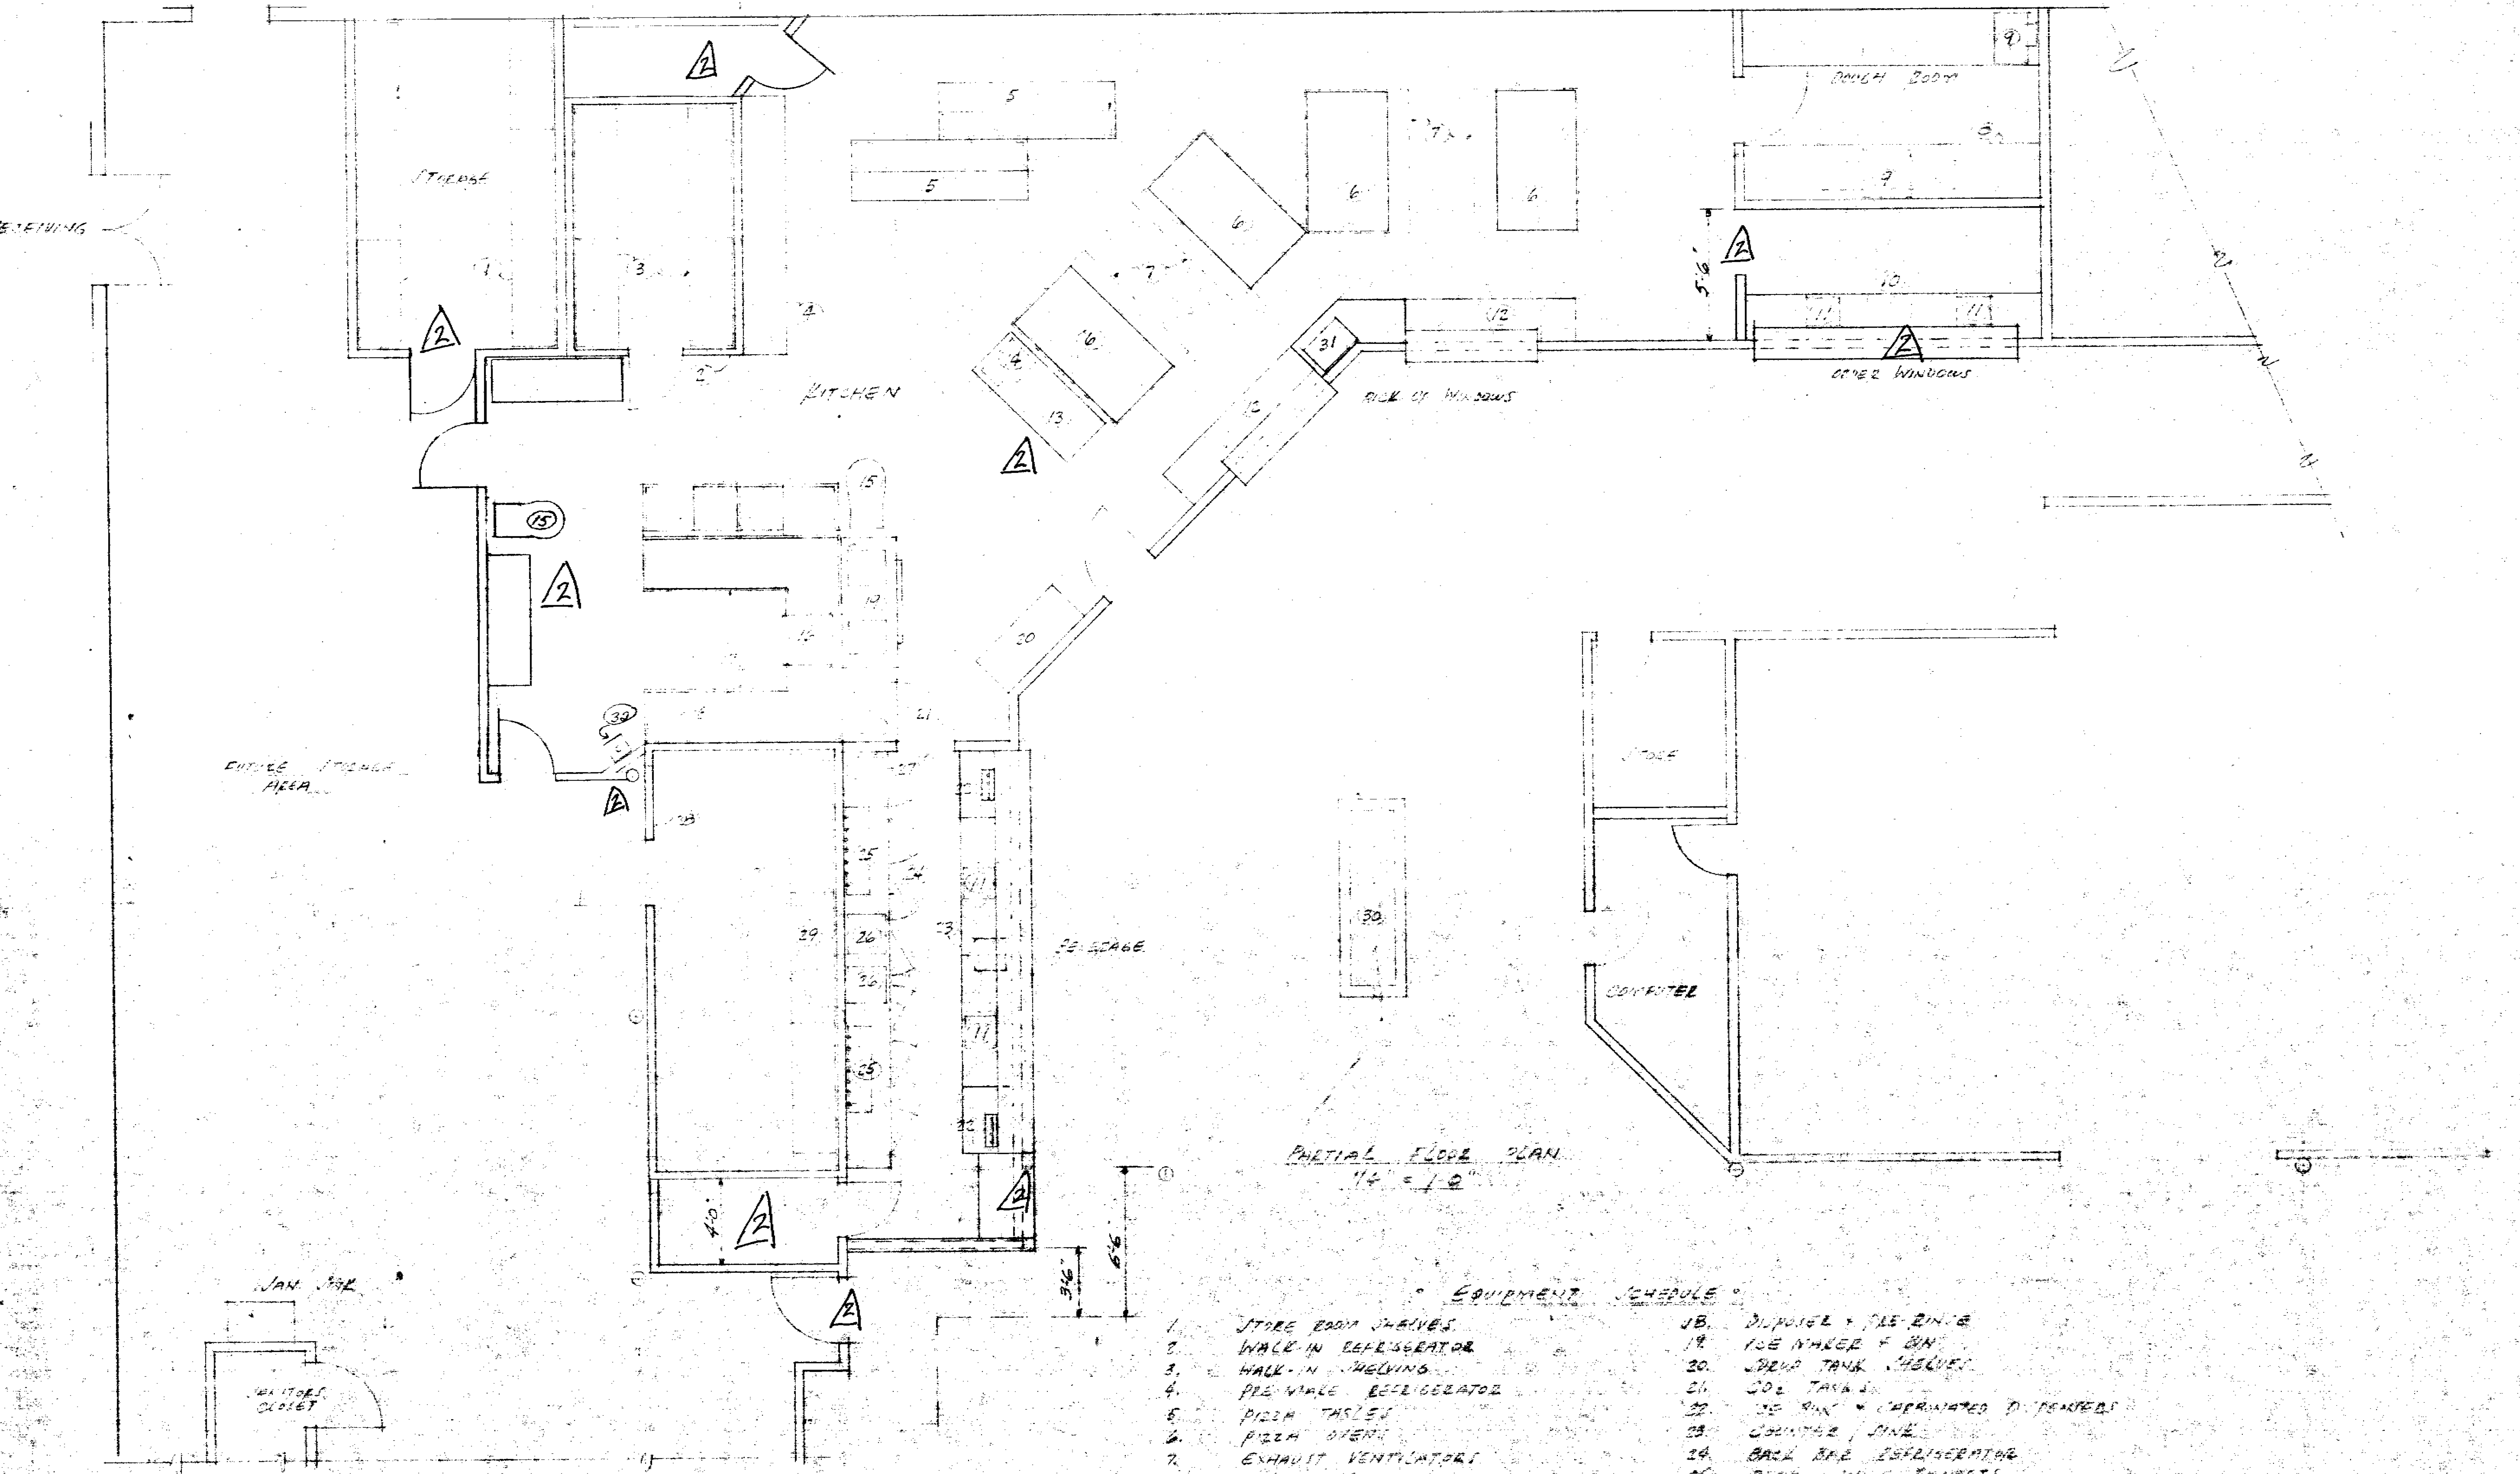

PARTIAL FLOOR PLAN
1/4" = 1'-0"

° EQUIPMENT SCHEDULE °

1. STORE ROOM SHELVES
2. WALK-IN REFRIGERATOR
3. WALK-IN SHELVING
4. PRE-MAKE REFRIGERATOR
5. PIZZA TABLES
6. PIZZA OVENS
7. EXHAUST VENTILATORS
8. DOUGH ROLLING TABLE
9. DOUGH ROLLER
10. ORDER COUNTER
11. CASH REGISTERS
12. PIZZA CUTTING TABLES
13. WORK TABLE
14. SLICER
15. MIXER
16. DISHWASHER
17. SOILED & CLEAN TABLES
18. DISPOSER & PRE-RINSE
19. ICE MAKER & BIN
20. SYRUP TANK SHELVES
21. CO2 TANKS
22. ICE BIN & CARBONATED DISPENSERS
23. COUNTER / SINK
24. BACK BAR REFRIGERATOR
25. BEER & WINE FAUCETS
26. YOGURT MACHINES
27. COFFEE MAKER
28. WALK-IN REFRIGERATOR
29. WALK-IN SHELVING
30. SALAD BAR
31. ROLL-A-GRILL
32. SINK

4

PIZZA TIME THEATRE
SAN JOSE, CA.

REV A
9

P/C 15480

ELECTRICAL PANELS
2
ELECT. OUTLET FOR (2) 100 WATT LIGHTS + BLOWER CTRL. 115/60/1
PLUG + 3'-6 115/60/1
DRN DRAINS TO F.S.
FLOOR SINK
(2) 3/4" GAS 280,000 BTU
PLUGS (2) 1/2 HP + 12" 115/60/1
(2) 3/4" GAS 280,000 BTU
(2) 3/4" GAS 280,000 BTU
(2) 3/4" GAS 280,000 BTU
SEE DETAIL THIS SHEET FOR EXHAUST VENT. + DUCTS TO BAKE OVENS
PLUG 1 HP. + 4'-0" 208/60/3 Ø
PLUG 1.7 KW. + 60" 115/60/1
PLUG + 12" 115/60/1
SWITCHES + PILOT LIGHTS TO EXHAUST FANS ON ROOF
PLUG + 3'-3 115/60/1 SEPARATE CKT WITH GRD FOR EACH PLUG
PLUG 1.7 KW. + 60" 115/60/1
PLUG + 12" 115/60/1
OPENINGS IN ROOF TO VENT TO BE PROPERLY FRAMED WITH HEADERS.
EXHAUST FAN 4000 CFM
FLASHING
6" HIGH CURB
EXIST. ROOF
3" MIN.
PROVIDE 1-HR. SHEET ROCK ENCLOSURE
DUCT 18" DIA.
DUCT
EXHAUST VENTILATORS
PIZZA OVENS
SECTION THRU OVEN EXHAUST SYSTEMS
1 1/2" WASTE
1 1/2 HP PROVIDE CORD + PLUG +12" 208/60/3 Ø
1 1/2 HP. PROVIDE CORD + PLUG. + 12" 208/60/3 Ø
(2) 1 HP + 72" 208/60/1 Ø
3/4" HOT WATER + 12"
(2) 1-HP MOTORS + 5 KW HEATER + 112" 208/60/3 Ø
2" WASTE TO F.S.
1/2" COLD WATER + 12" BRANCH TO ICE MAKERS
1/2" HOT WATER + 12"
1 1/2" WASTE + 12"
1/2" HOT WATER + 12"
1/2" COLD WATER + 12"
3/4 HP + 12" 208/60/1 Ø.
(2) PLUGS 3 HP + 5'-6" 115/60/1
FLOOR SINK
PLUG 1.7 KW. 115/60/1
PLUG + 18" 115/60/1
PLUG + 3'-3" 115/60/1 SEPARATE CKT WITH GRD
3
FLOOR SINK
1/2" HOT WATER + 3"
1/2" COLD WATER + 8" BRANCH TO CARBONATORS
PLUG + 3'-3" 115/60/1 SEPARATE CKT WITH GRD
PLUG + 18" 115/60/1
DRN DRAINS TO F.S.
ELECT. OUTLET FOR (2) 100 WATT LIGHTS + BLOWER CTRL. 115/60/1
PLUG + 12" 115/60/1
FLOOR SINK

MECHANICAL, ELECTRICAL + PLUMBING FOR
FOOD SERVICE EQUIPMENT

PIZZA TIME THEATRE
SAN JOSE, CA

REV. 10/25

P/C 15480

12341

5

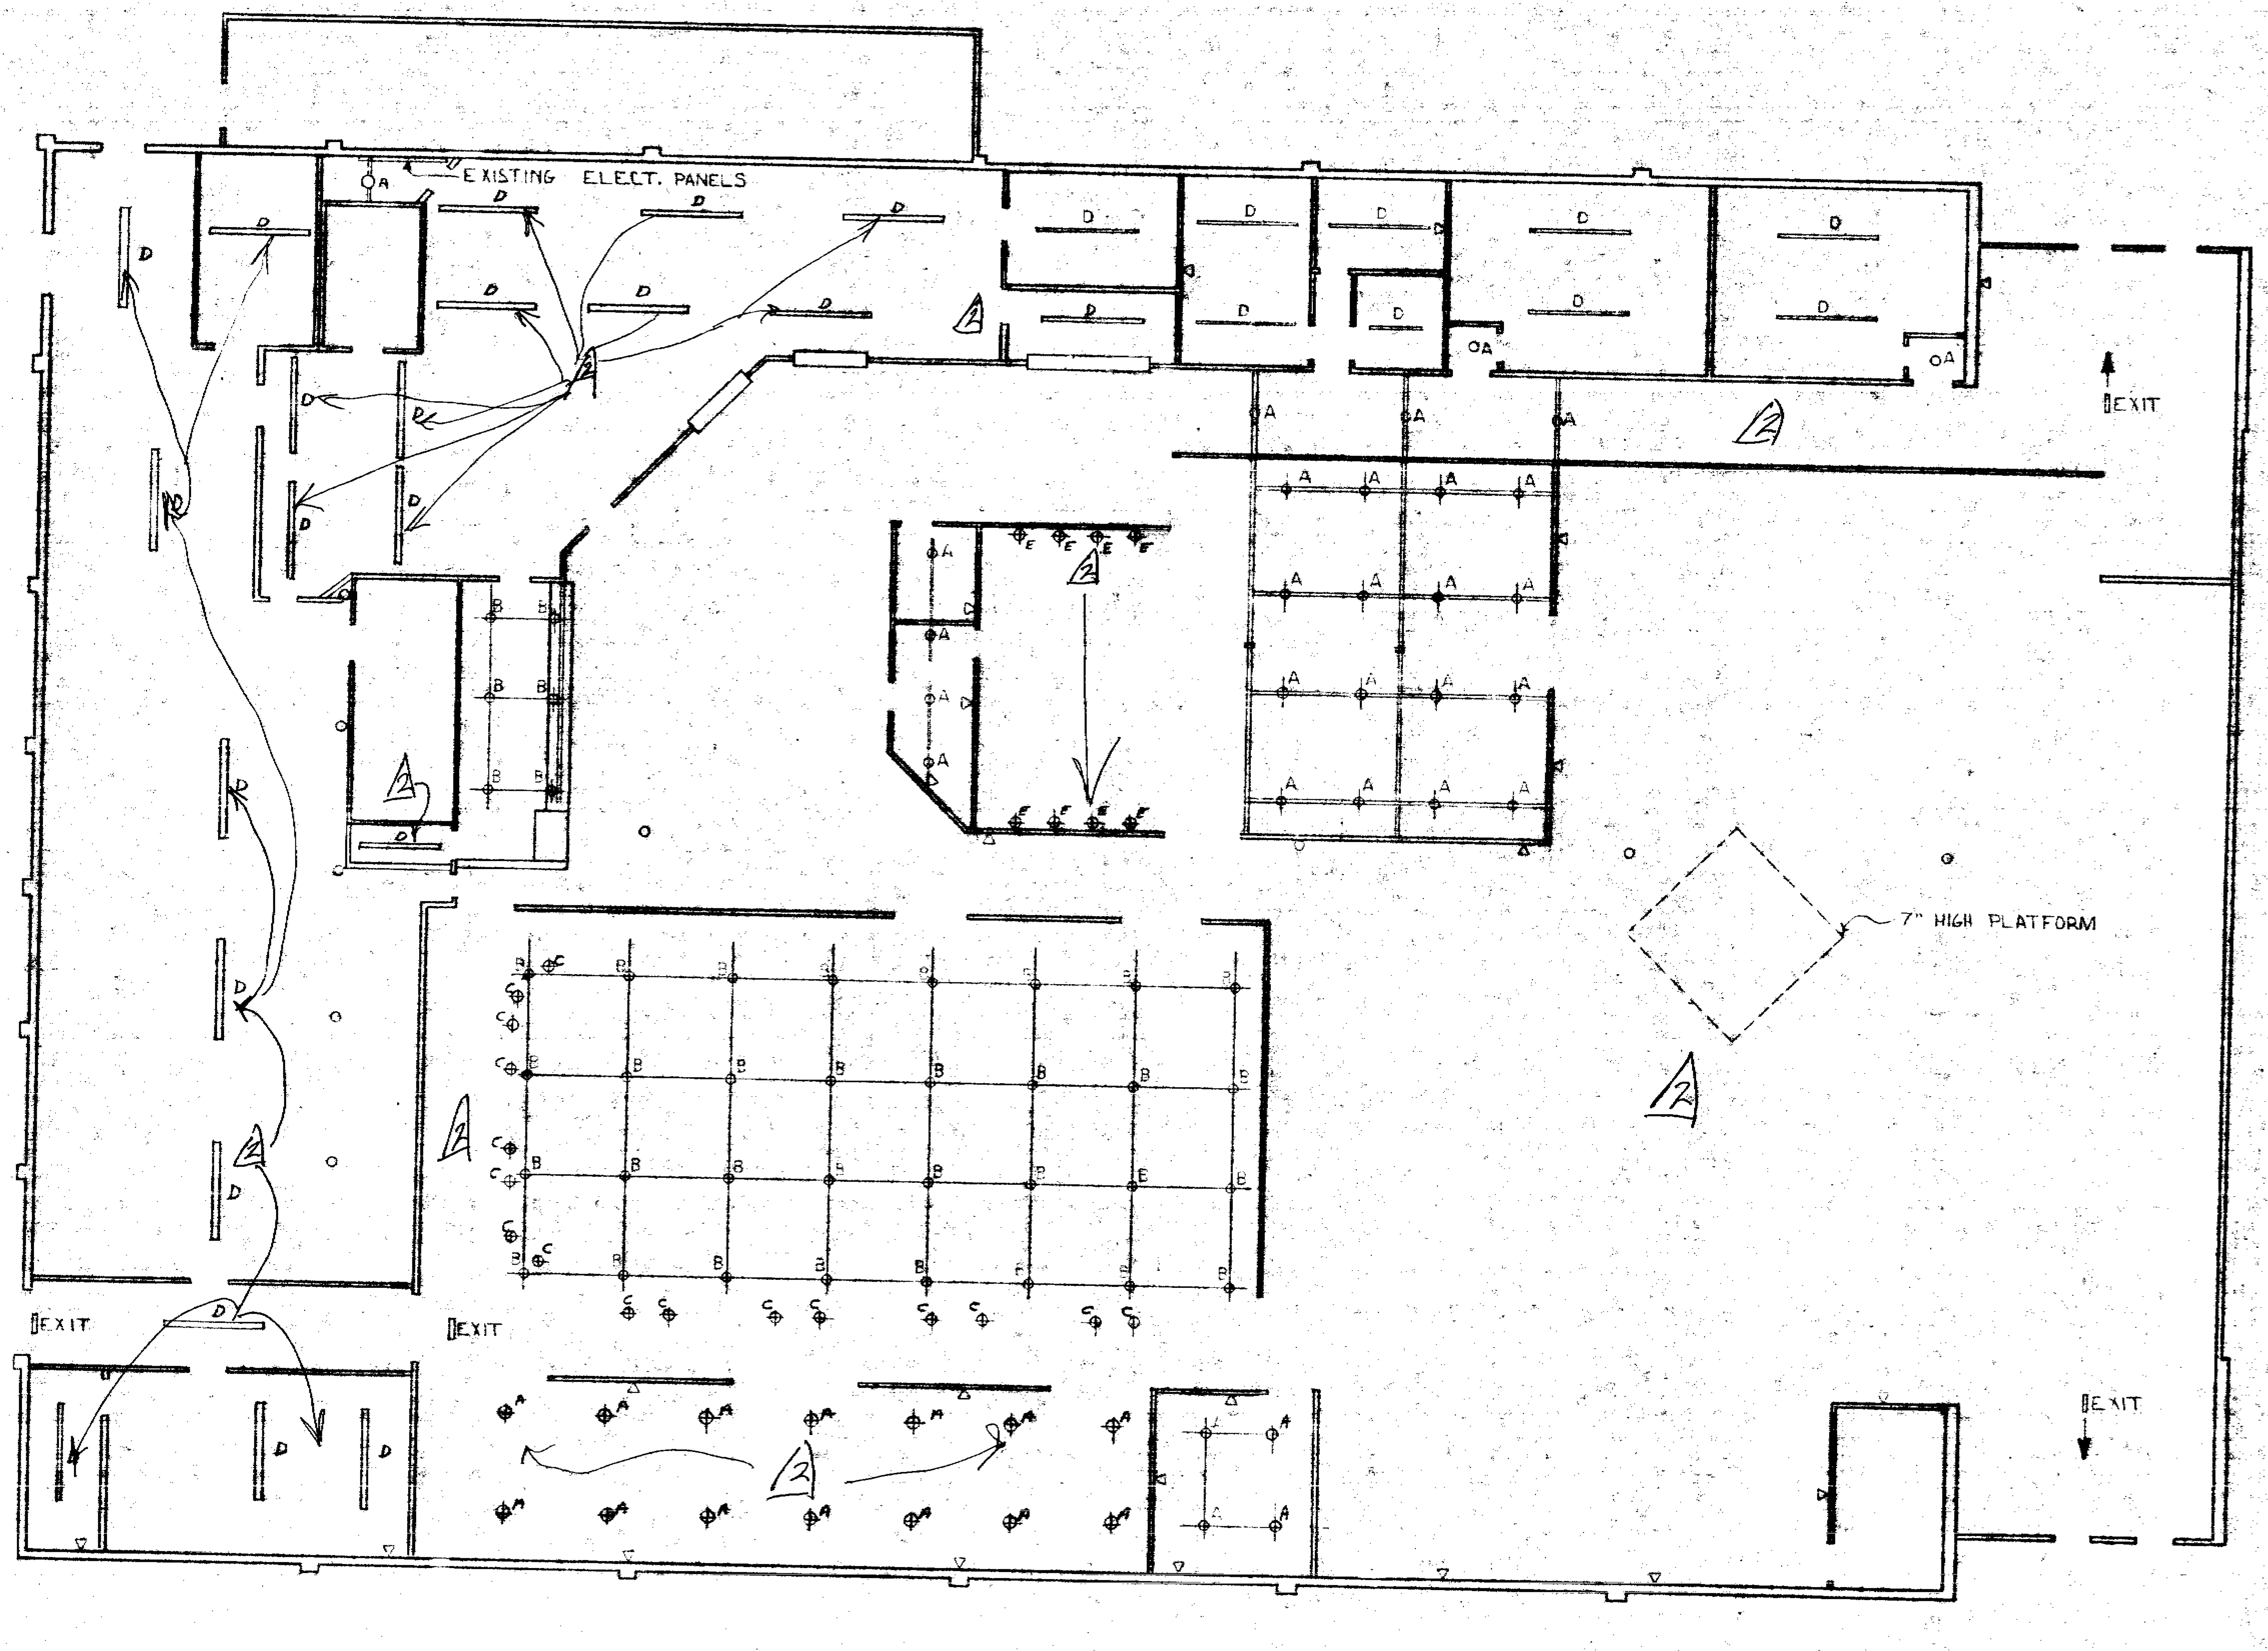

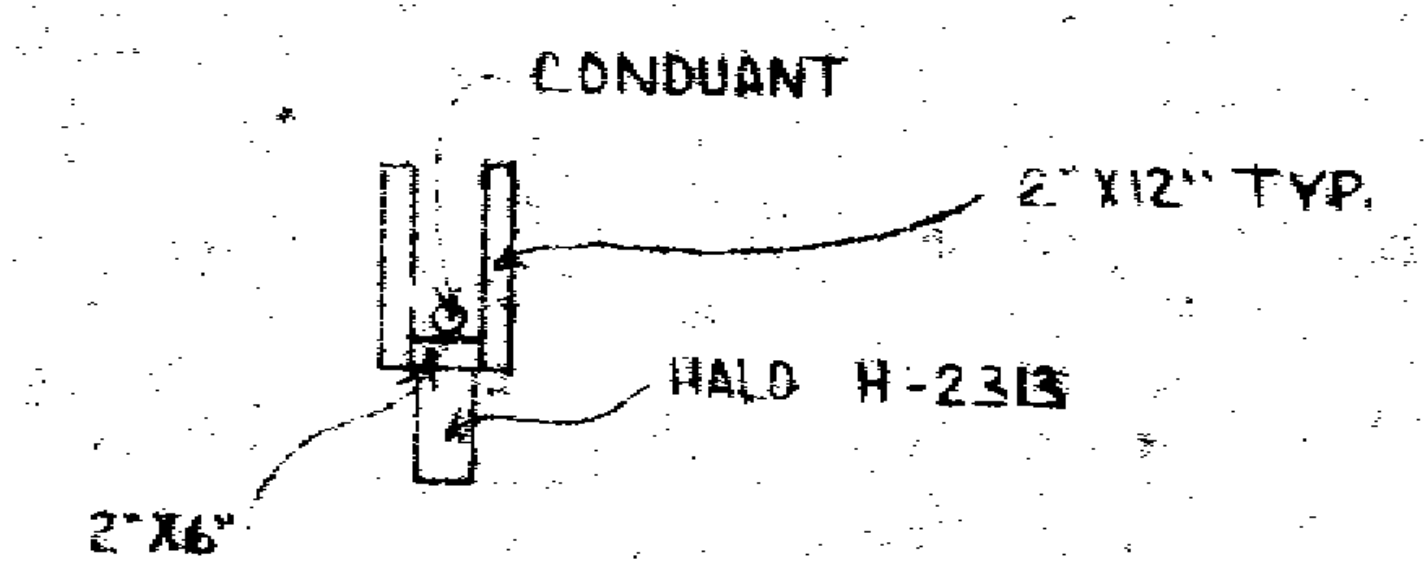

LIGHT MOUNTING DETAIL
FOR FIXTURE "A" 2

FIXTURE SCHEDULE

A. HALO H-2313 SURFACE MOUNT CYLINDER, 75 WATT R-30 LAMPS.

2 B. HALO H-2313 TO BE HUNG AT 12'-0" WITH TUBULAR SUPPORT HANGERS.

2 C. HALO L 973 CANOPY ADAPTER FOR PENDANT MOUNT HUNG AT 13' 0", 4'-0" LONG RUN TO INDIVIDUAL SWITCHES PROVIDE (24) LIGHTS.

D. SURFACE MOUNT (2) LIGHT FLOURESCENT FIXTURES, SWITCH TO PANEL.

▽ WHERE SHOWN PROVIDE 20 AMP 115/60/1Ø PLUG OUTLET, IN WALL 12" UP FROM FLOOR. IN FLOOR PROVIDE FLUSH SCREW COVER.

PROVIDE EXIT & EMERGENCY LIGHTS AS REQUIRED BY THE FIRE MARSHALL.

EXITING LIGHTING TO REMAIN FOR ALL AREAS. RELAMP AS DIRECTED BY OWNER.

2 E. HALO L512 SURFACE MOUNT 7'-0" FROM FLOOR.

6

12341

Pizza Time Theatre Inc.
455 N. Bernardo Avenue
Suite A
Mountain View, CA 94043

© 1978 Pizza Time Theatre Inc.

NOTICE TO ALL PERSONS RECEIVING THIS DRAWING CONFIDENTIAL: Reproduction Forbidden without the specific written permission of Pizza Time Theatre Inc., Mountain View, California. This drawing is only conditionally issued, and neither receipt nor possession thereof confers or transfers any right in, or license to use, the subject matter of the drawing or any design or technical information shown thereon, nor any right to reproduce this drawing or any part thereof, except for manufacture by vendors for Pizza Time Theatre Inc. and for manufacture under the corporation's written license, no right to reproduce this drawing is granted or the subject matter thereof unless by written agreement with or written permission from the corporation.

REV. B
DRAWN BY: [illegible] 78
TITLE:
SCALE: [illegible]
SHEET [illegible]

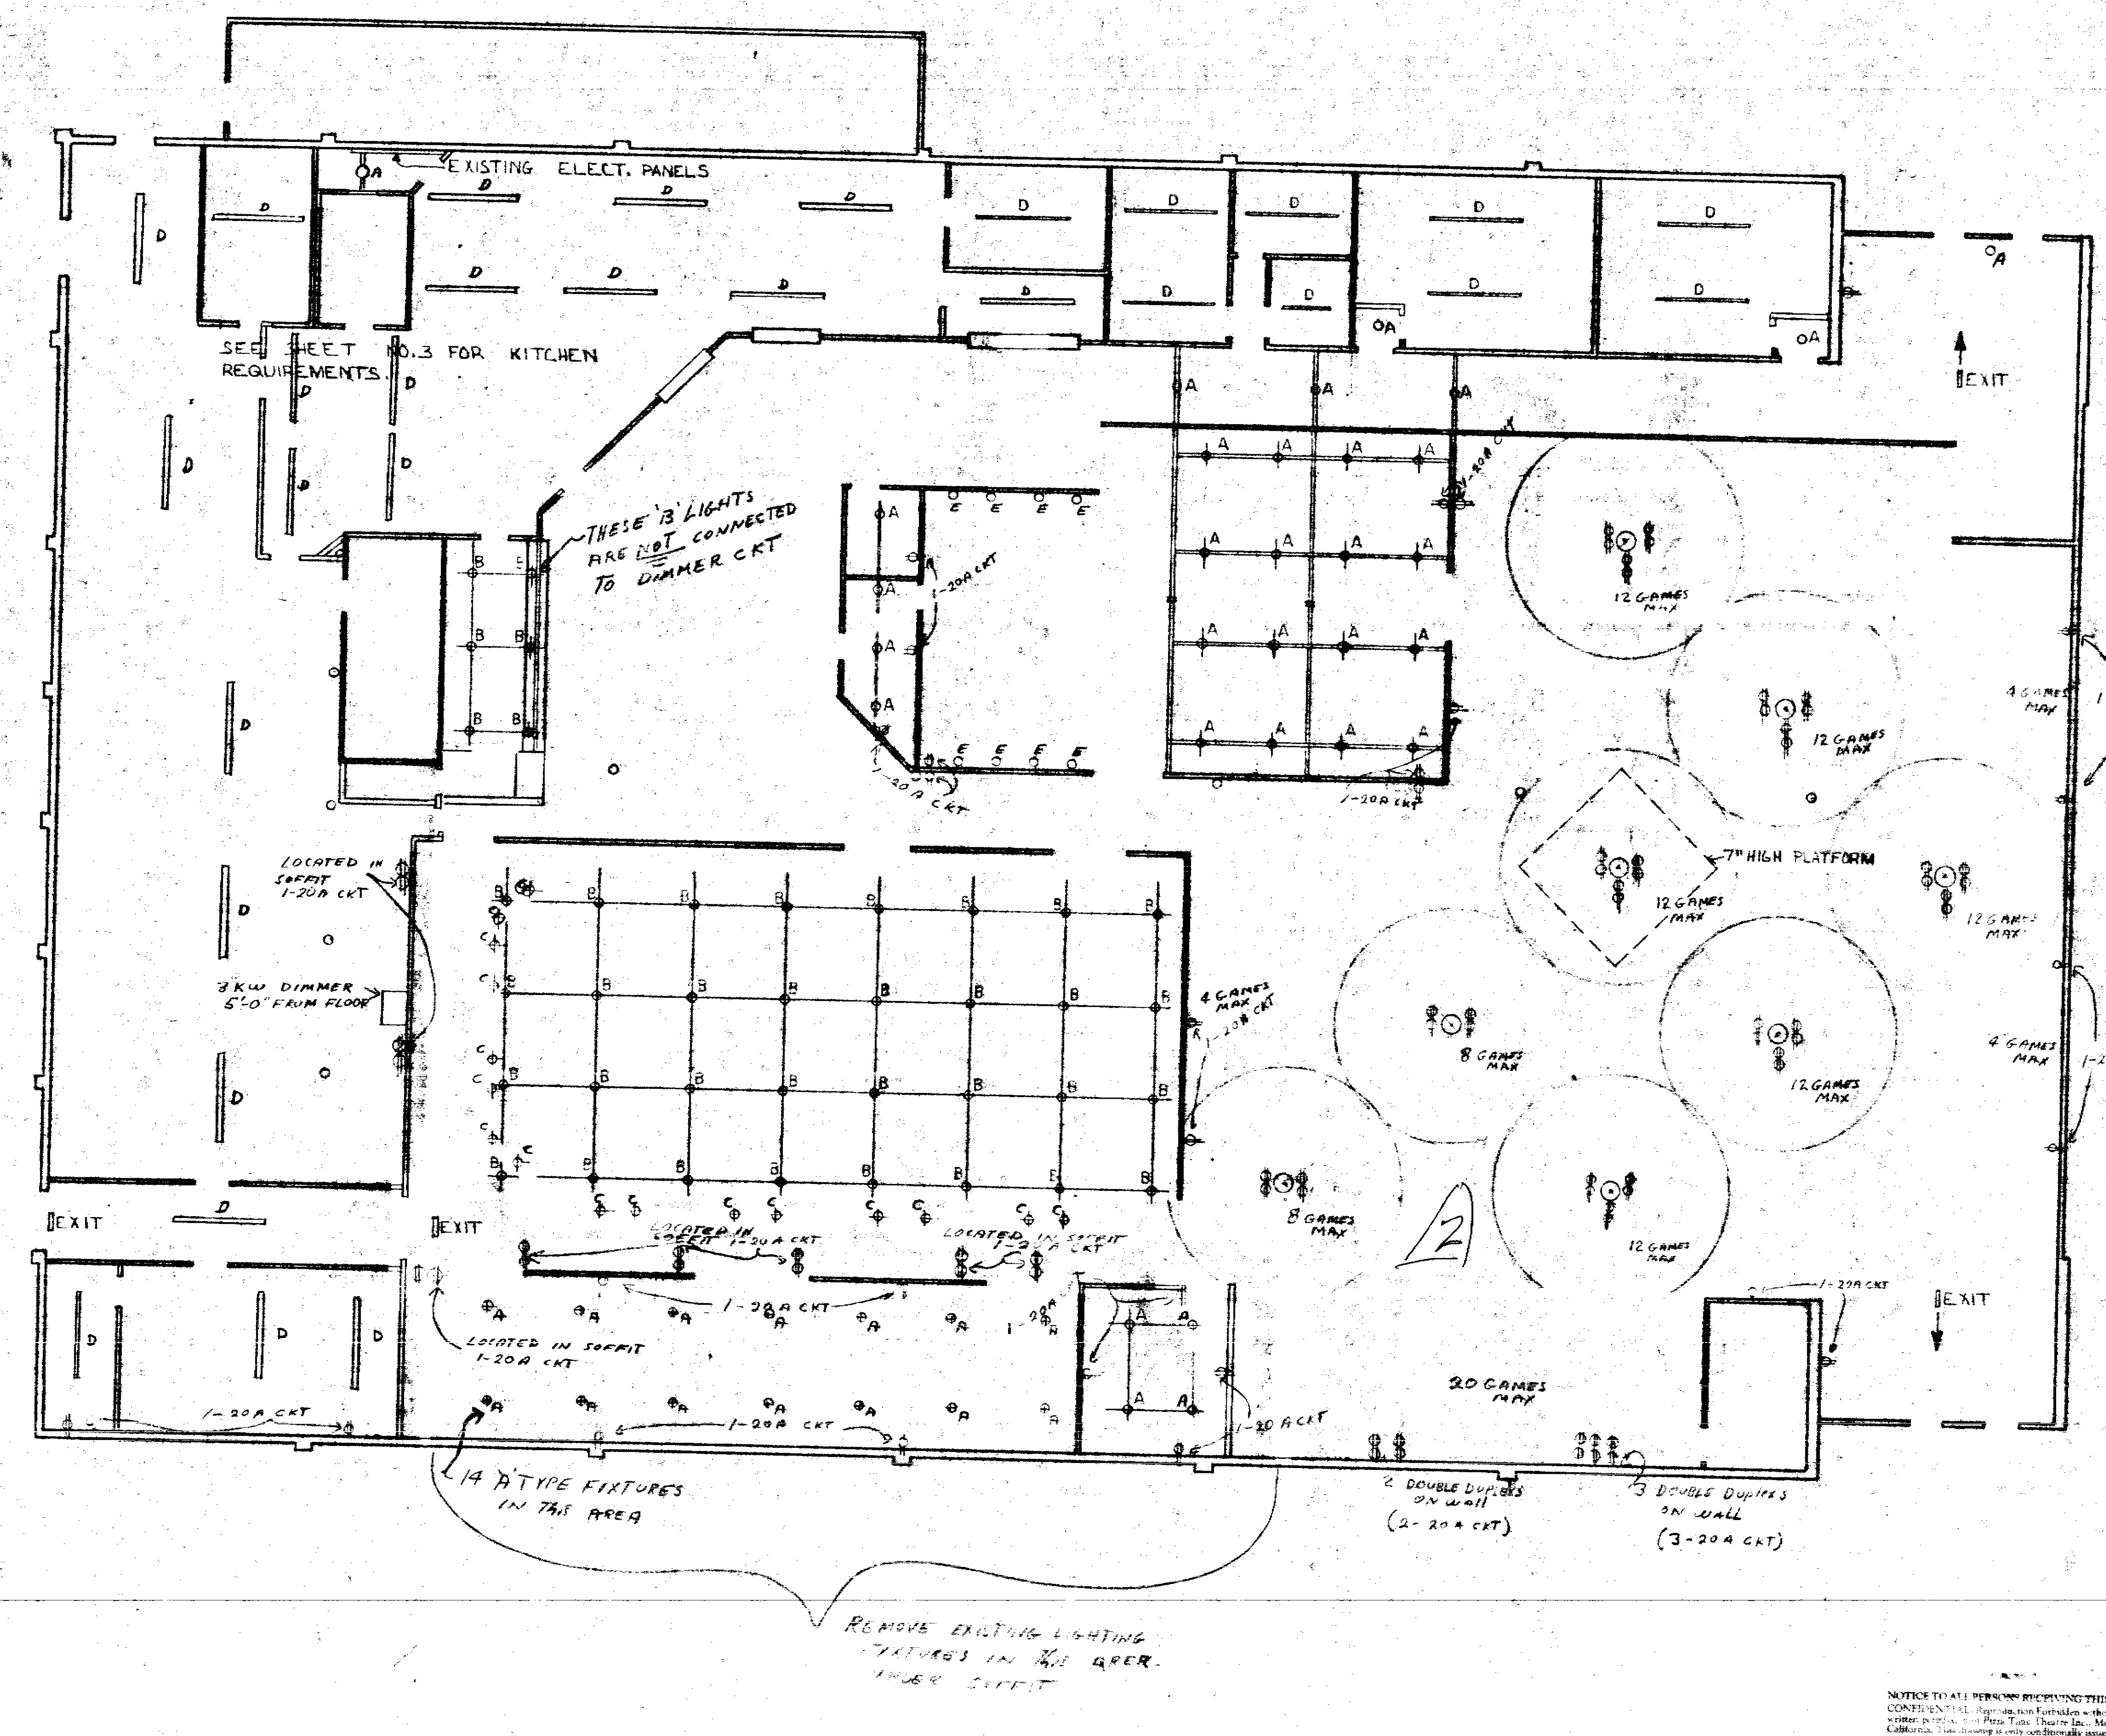
EXISTING ELECT. PANELS
SEE SHEET NO.3 FOR KITCHEN REQUIREMENTS.
THESE 'B' LIGHTS ARE NOT CONNECTED TO DIMMER CKT
7" HIGH PLATFORM
LOCATED IN SOFFIT 1-20A CKT
8 KW DIMMER 5'-0" FROM FLOOR
12 GAMES MAX
8 GAMES MAX
4 GAMES MAX
20 GAMES MAX
1-20A CKT
EXIT
14 'A' TYPE FIXTURES IN THIS AREA
2 DOUBLE DUPLEXS ON WALL (2-20A CKT)
3 DOUBLE DUPLEXS ON WALL (3-20A CKT)
REMOVE EXISTING LIGHTING FIXTURES IN THE AREA UNDER SOFFIT
DUPLEX

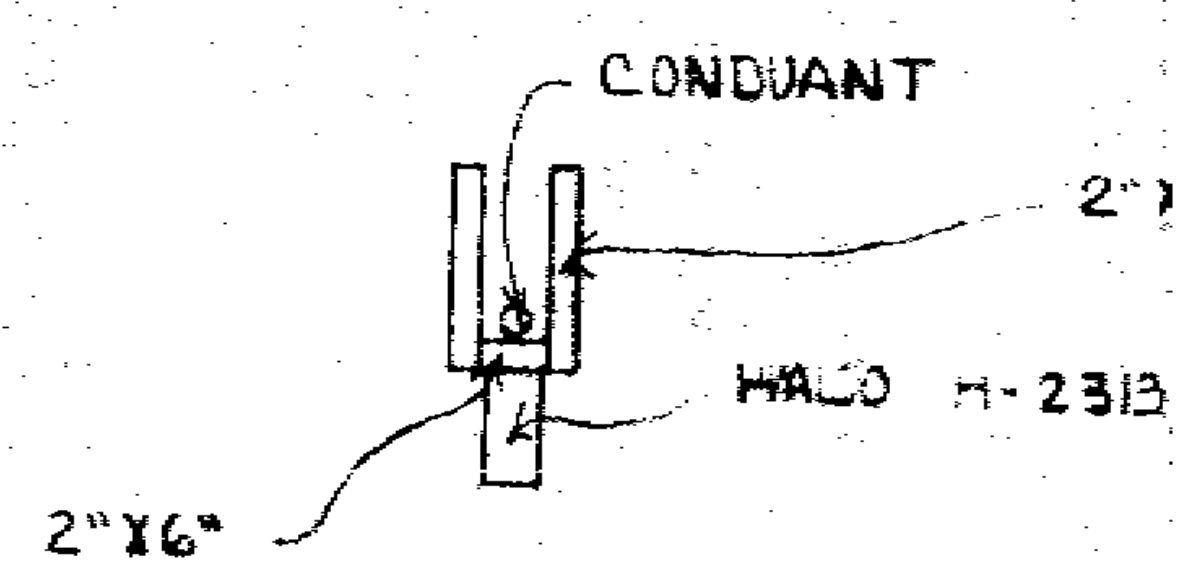

LIGHT MOUNTING DETAIL FOR FIXTURE "A"

FIXTURE SCHEDULE

A. HALO H-2313 SURFACE MOUNT CY
75 WATT R-30 LAMPS.
B. HALO H-2313 TO BE HUNG AT
12'-0" WITH TUBULAR SUPPORT AN
C. HALO L 973 CANOPY ADAPTER FOR PENDA
HUNG AT 12'-0", 4'-0" LONG RUN TO
INDIVIDUAL SWITCHES PROVIDE (24)
D. SURFACE MOUNT (2) LIGHT FLOURES
FIXTURES, SWITCH TO PANEL.
⏀ WHERE SHOWN PROVIDE 20 AMP
PLUG OUTLET, IN WALL 12" UP
FLOOR.

PROVIDE EXIT & EMERGENCY L
AS REQUIRED BY THE FIRE M

⏀⏀ WHERE SHOWN PROVIDE 20 AMP 11
DOUBLE DUPLEX OUTLET, IN WALL
PIPE 12" UP FROM FLOOR

EXITING LIGHTING TO REMAIN FO
AREAS. RELAMP AS DIRECTED B

E. HALO L512 SURFACE MOUNT 40"

7

Pizza Time Theatre Inc.
455 N. Bernardo Avenue
Suite A
Mountain View, CA 940

© Pizza Time Theatre Inc.

NOTICE TO ALL PERSONS RECEIVING THIS DRAWING
CONFIDENTIAL: Reproduction Forbidden without the specific written permission of Pizza Time Theatre Inc., Mountain View, California. This drawing is only conditionally issued, and neither receipt nor possession thereof confers or transfers any right in, or license to use, the subject matter of the drawing or any design or technical information shown thereon, nor any right to reproduce this drawing or any part thereof, except for manufacture by vendors for Pizza Time Theatre Inc. and for manufacture under the corporation's [illegible], no right to reproduce this drawing is granted or the subject matter thereof unless by written agreement with or written permission from the corporation.

DRAWN BY: [illegible]

2

	SQ. FT.	SEATS	PARKING
THEATRE DINING	2368	152	60.8
ADULT DINING	1254	67	26.8
PRIVATE DINING	840	40	16.0
TOTALS	4142	259	103.6

WOMENS
PROVIDE (5) WATER CLOSETS, (3) LAVARTORIES, MIRRORS, SOAP DISPENSERS TOWEL DISPENSERS ONE TOILET ENCLOSURE TO HAVE 2'-8" DOOR AND GRAB BARS.

MENS
PROVIDE 2 WATER CLOSETS 3 URINALS 3 LAVATORIES MIRRORS SOAP DISP. TOWEL DISPENSERS ONE TOILET ENCLOSURE TO HAVE 2'-8" DOOR AND GRAB BARS.

HANDICAPED REQUIREMENTS TO BE U.B.C. §1711

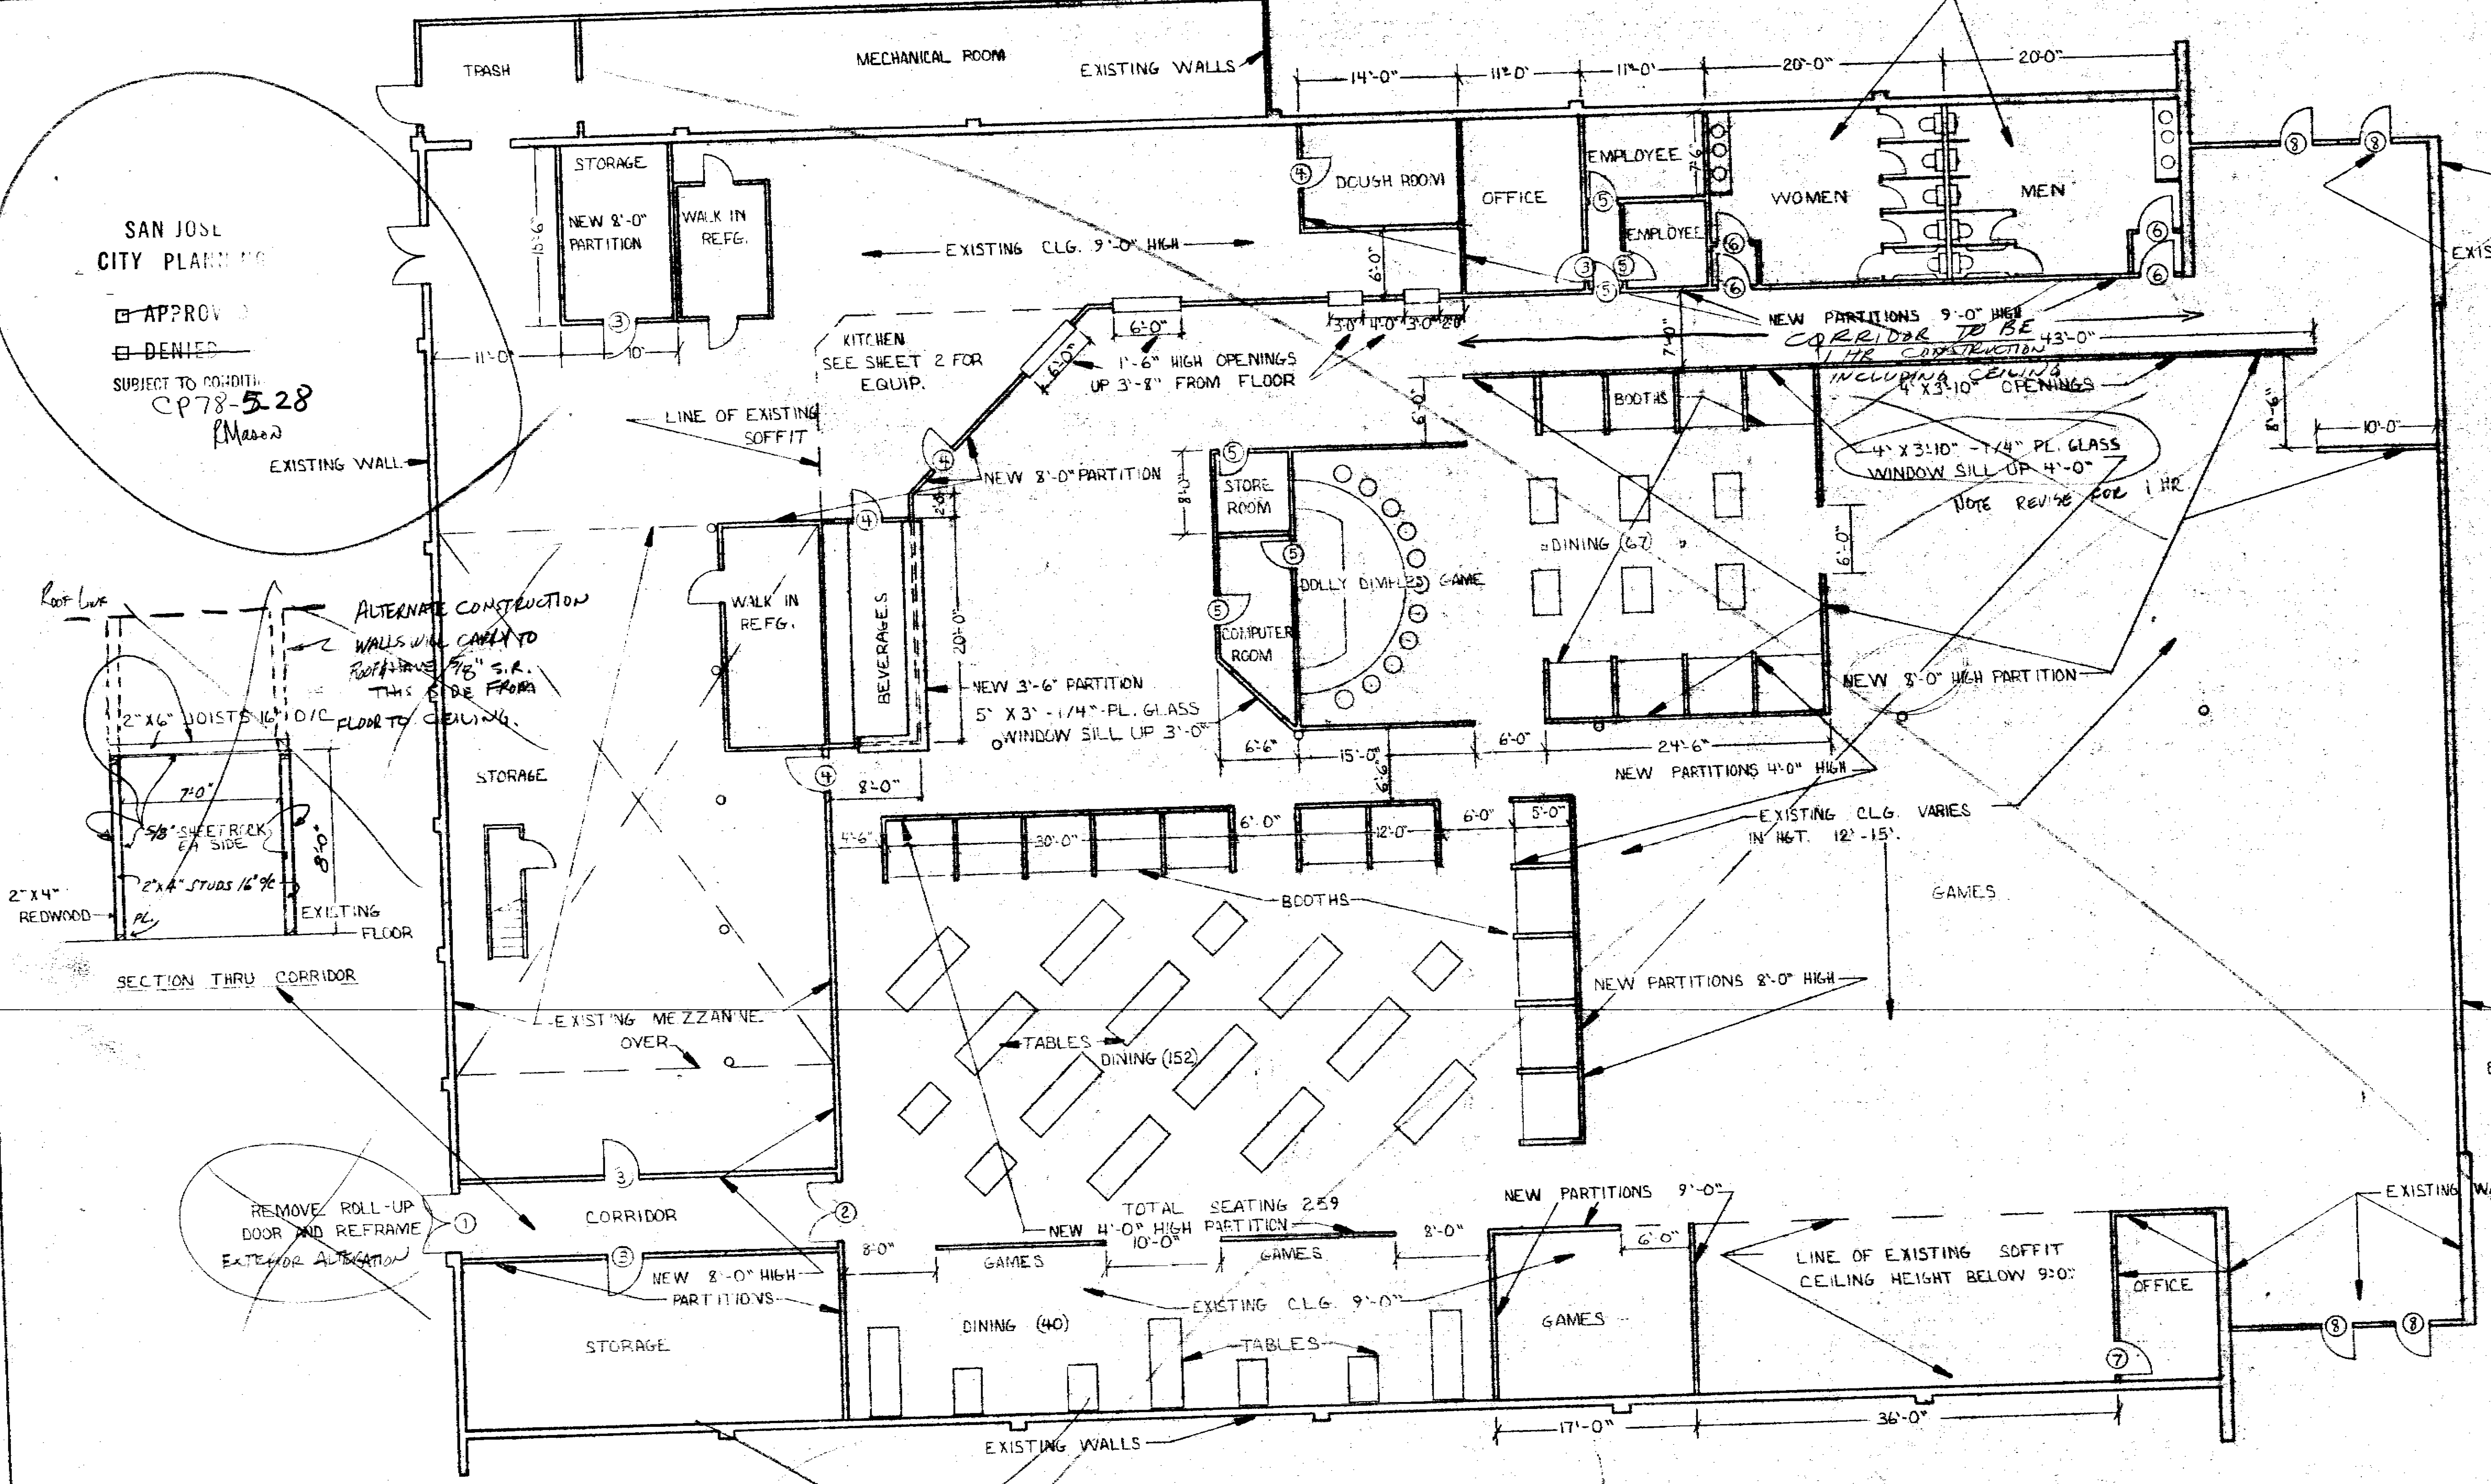

SAN JOSE
CITY PLANNING
☐ ~~APPROVED~~
☐ ~~DENIED~~
SUBJECT TO CONDITI
CP78-5.28
R Mason

12341

NOTES

1. ALL NEW PARTITIONS TO BE 2"X4" @16" O/C WITH 5/8 SHEET ROCK BOTH SIDES.
2. FINISH OF KITCHEN, DOUGH ROOM, STORAGE, MENS AND WOMENS TOILETS TO BE TWO (2) COATS SEMI-GLOSS ENAMEL LIGHT COLOR.
3. NO STRUCTURAL CHANGES ARE TO BE MADE.
4. IN KITCHEN PROVIDE (2) 20-B-C FIRE EXTINGUSHERS. IN DINING PROVIDE (2) 2-A-10B-C FIRE EXTINGUSHERS.
5. ALL WOOD PANELING OR DECORATIVE MATERIALS SHALL BE FLAME TREATED.

NOT REQ'D FOR PREVIOUSLY CONDITIONED

~~ELECTRICAL & PLUMBING/MECH PERMITS REQ'D. TITLE 24 ENERGY REQUIREMENTS MUST BE MET. SUBMIT CALCULATIONS TO ELEC & PLUMBING/MECH SECTIONS.~~

SUPERSEDED
ORIGINAL
SEE REVISED 2
10/27/78

DOOR SCHEDULE

NO.	SIZE	TYPE	MISC.
1.	3°-6⁸	SOLID CORE	PANIC HARDWARE CLOSER
2.	3°-6⁸	HOL. CORE	" "
3.	3°-6⁸	SOLID CORE	DEAD BOLT LOCK W/ CLOSER
4.	3°-6⁸	HOL. CORE	NO LOCK CLOSER
5.	3°-6⁸	HOL. CORE	DEAD BOLT LOCK W/ CLOSER
6.	2'°-6⁸	HOL. CORE	CLOSER W/ CLOSER
7.	EXISTING		ADD DEAD BOLT LOCK
8.	"		ADD PANIC HARDWARE

ALL DOORS UNLISTED ARE EXISTING WITH NO CHANGES.

ALL CORRIDOR DOORS TO HAVE 20 MIN LABEL ASSEMBLY WITH CLOSERS

FLOOR PLAN
1/8" = 1'-0" SCALE

NOTICE TO ALL PERSONS RECEIVING THIS DRAWING
CONFIDENTIAL: Reproduction Forbidden without the specific written permission of Pizza Time Theatre Inc., Mountain View, California. This drawing is only conditionally issued, and neither receipt nor possession thereof confers or transfers any right in, or license to use, the subject matter of the drawing or any design or technical information shown thereon, nor any right to reproduce this drawing or any part thereof, except for manufacture by vendors for Pizza Time Theatre Inc. and for manufacture under the corporation's written license, no right to reproduce this drawing is granted or the subject matter thereof unless by written agreement with or written permission from the corporation.

BLDG DEPT COPY

Pizza Time Theatre Inc.
455 N. Bernardo Avenue
Suite A
Mountain View, CA 94043

© 1978 Pizza Time Theatre Inc.

BY: DESIGN SERVICES
OF MENLO PARK CA.

8

SHEET ONE

P/C 15840

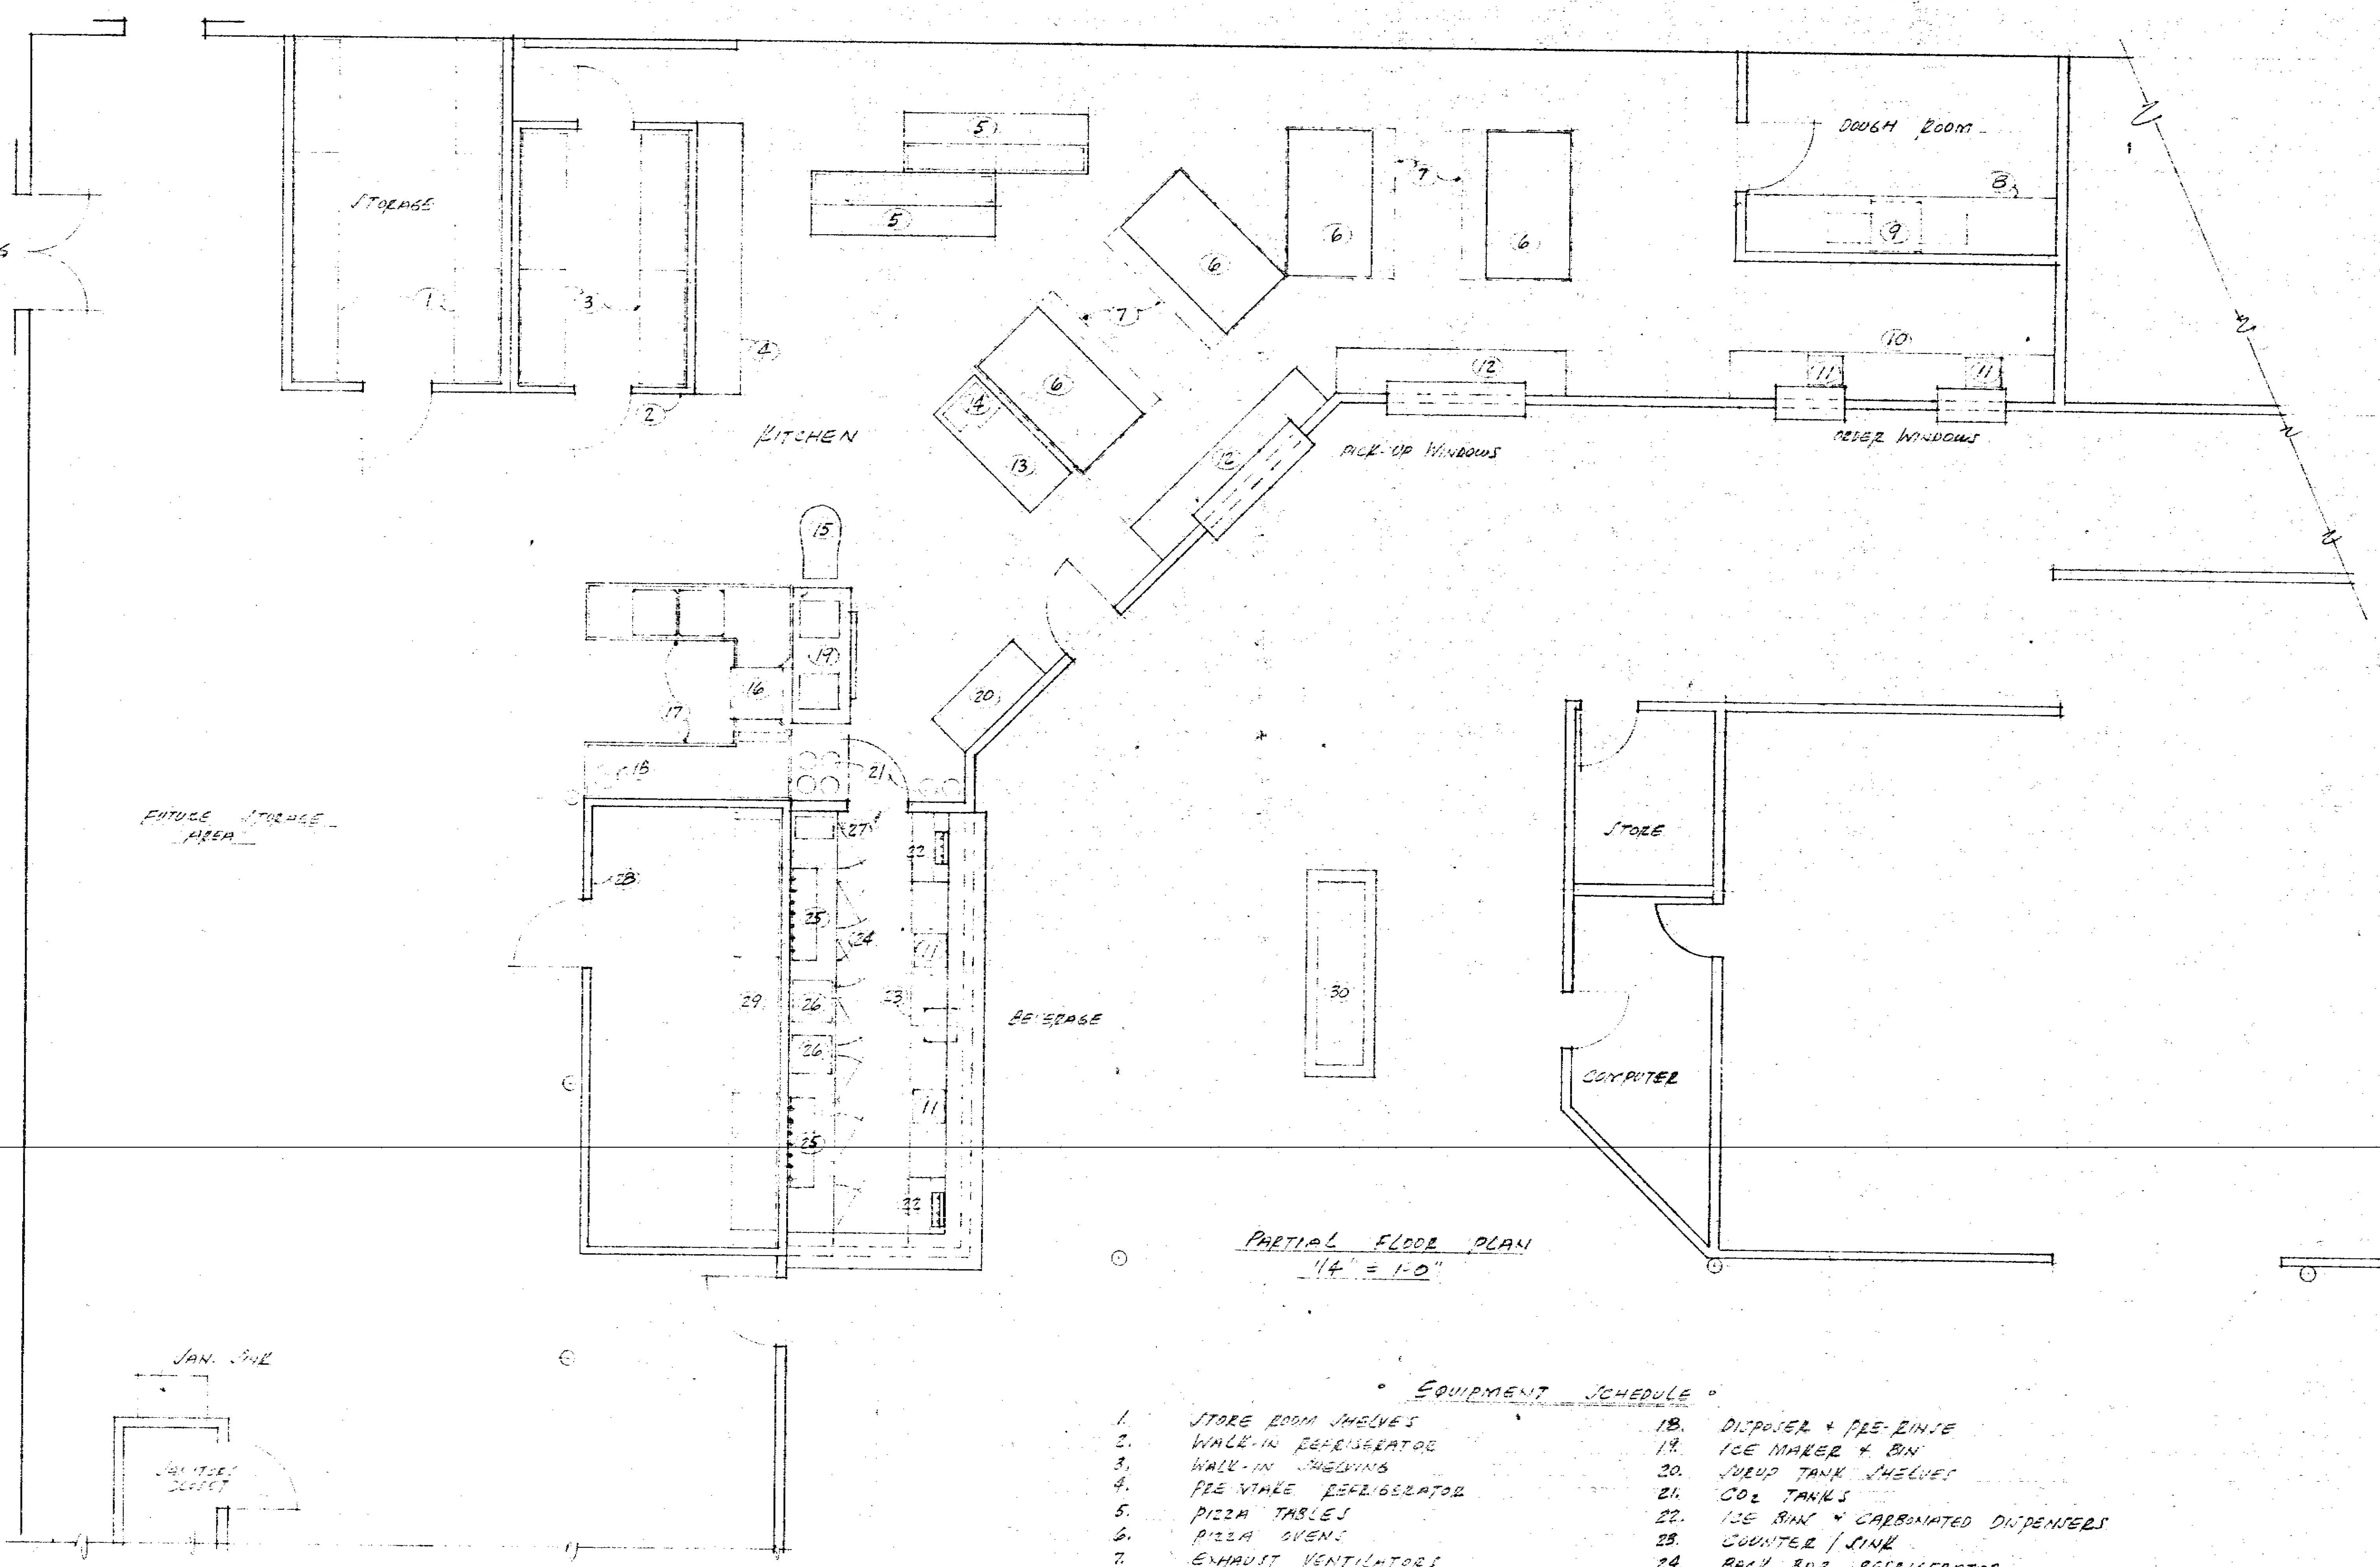

PARTIAL FLOOR PLAN
1/4" = 1'-0"

• EQUIPMENT SCHEDULE •

1. STORE ROOM SHELVES
2. WALK-IN REFRIGERATOR
3. WALK-IN SHELVING
4. PRE MAKE REFRIGERATOR
5. PIZZA TABLES
6. PIZZA OVENS
7. EXHAUST VENTILATORS
8. DOUGH ROLLING TABLE
9. DOUGH ROLLER
10. ORDER COUNTER
11. CASH REGISTERS
12. PIZZA CUTTING TABLES
13. WORK TABLE
14. SLICER
15. MIXER
16. DISHWASHER
17. SOILED & CLEAN TABLES.
18. DISPOSER & PRE-RINSE
19. ICE MAKER & BIN
20. SYRUP TANK SHELVES
21. CO_2 TANKS
22. ICE BIN & CARBONATED DISPENSERS
23. COUNTER / SINK
24. BACK BAR REFRIGERATOR
25. BEER & WINE FAUCETS
26. YOGURT MACHINES
27. COFFEE MAKER
28. WALK-IN REFRIGERATOR
29. WALK-IN SHELVING
30. SALAD BAR

SUPERSEDED
10/27/78 [illegible]
ORIGINAL
SEE REVISED
2

9

PIZZA TIME THEATRE
SAN JOSE, CA.
BY
DESIGN SERVICES
MENLO PARK, CA

12341

[redacted]

SHEET NO 2

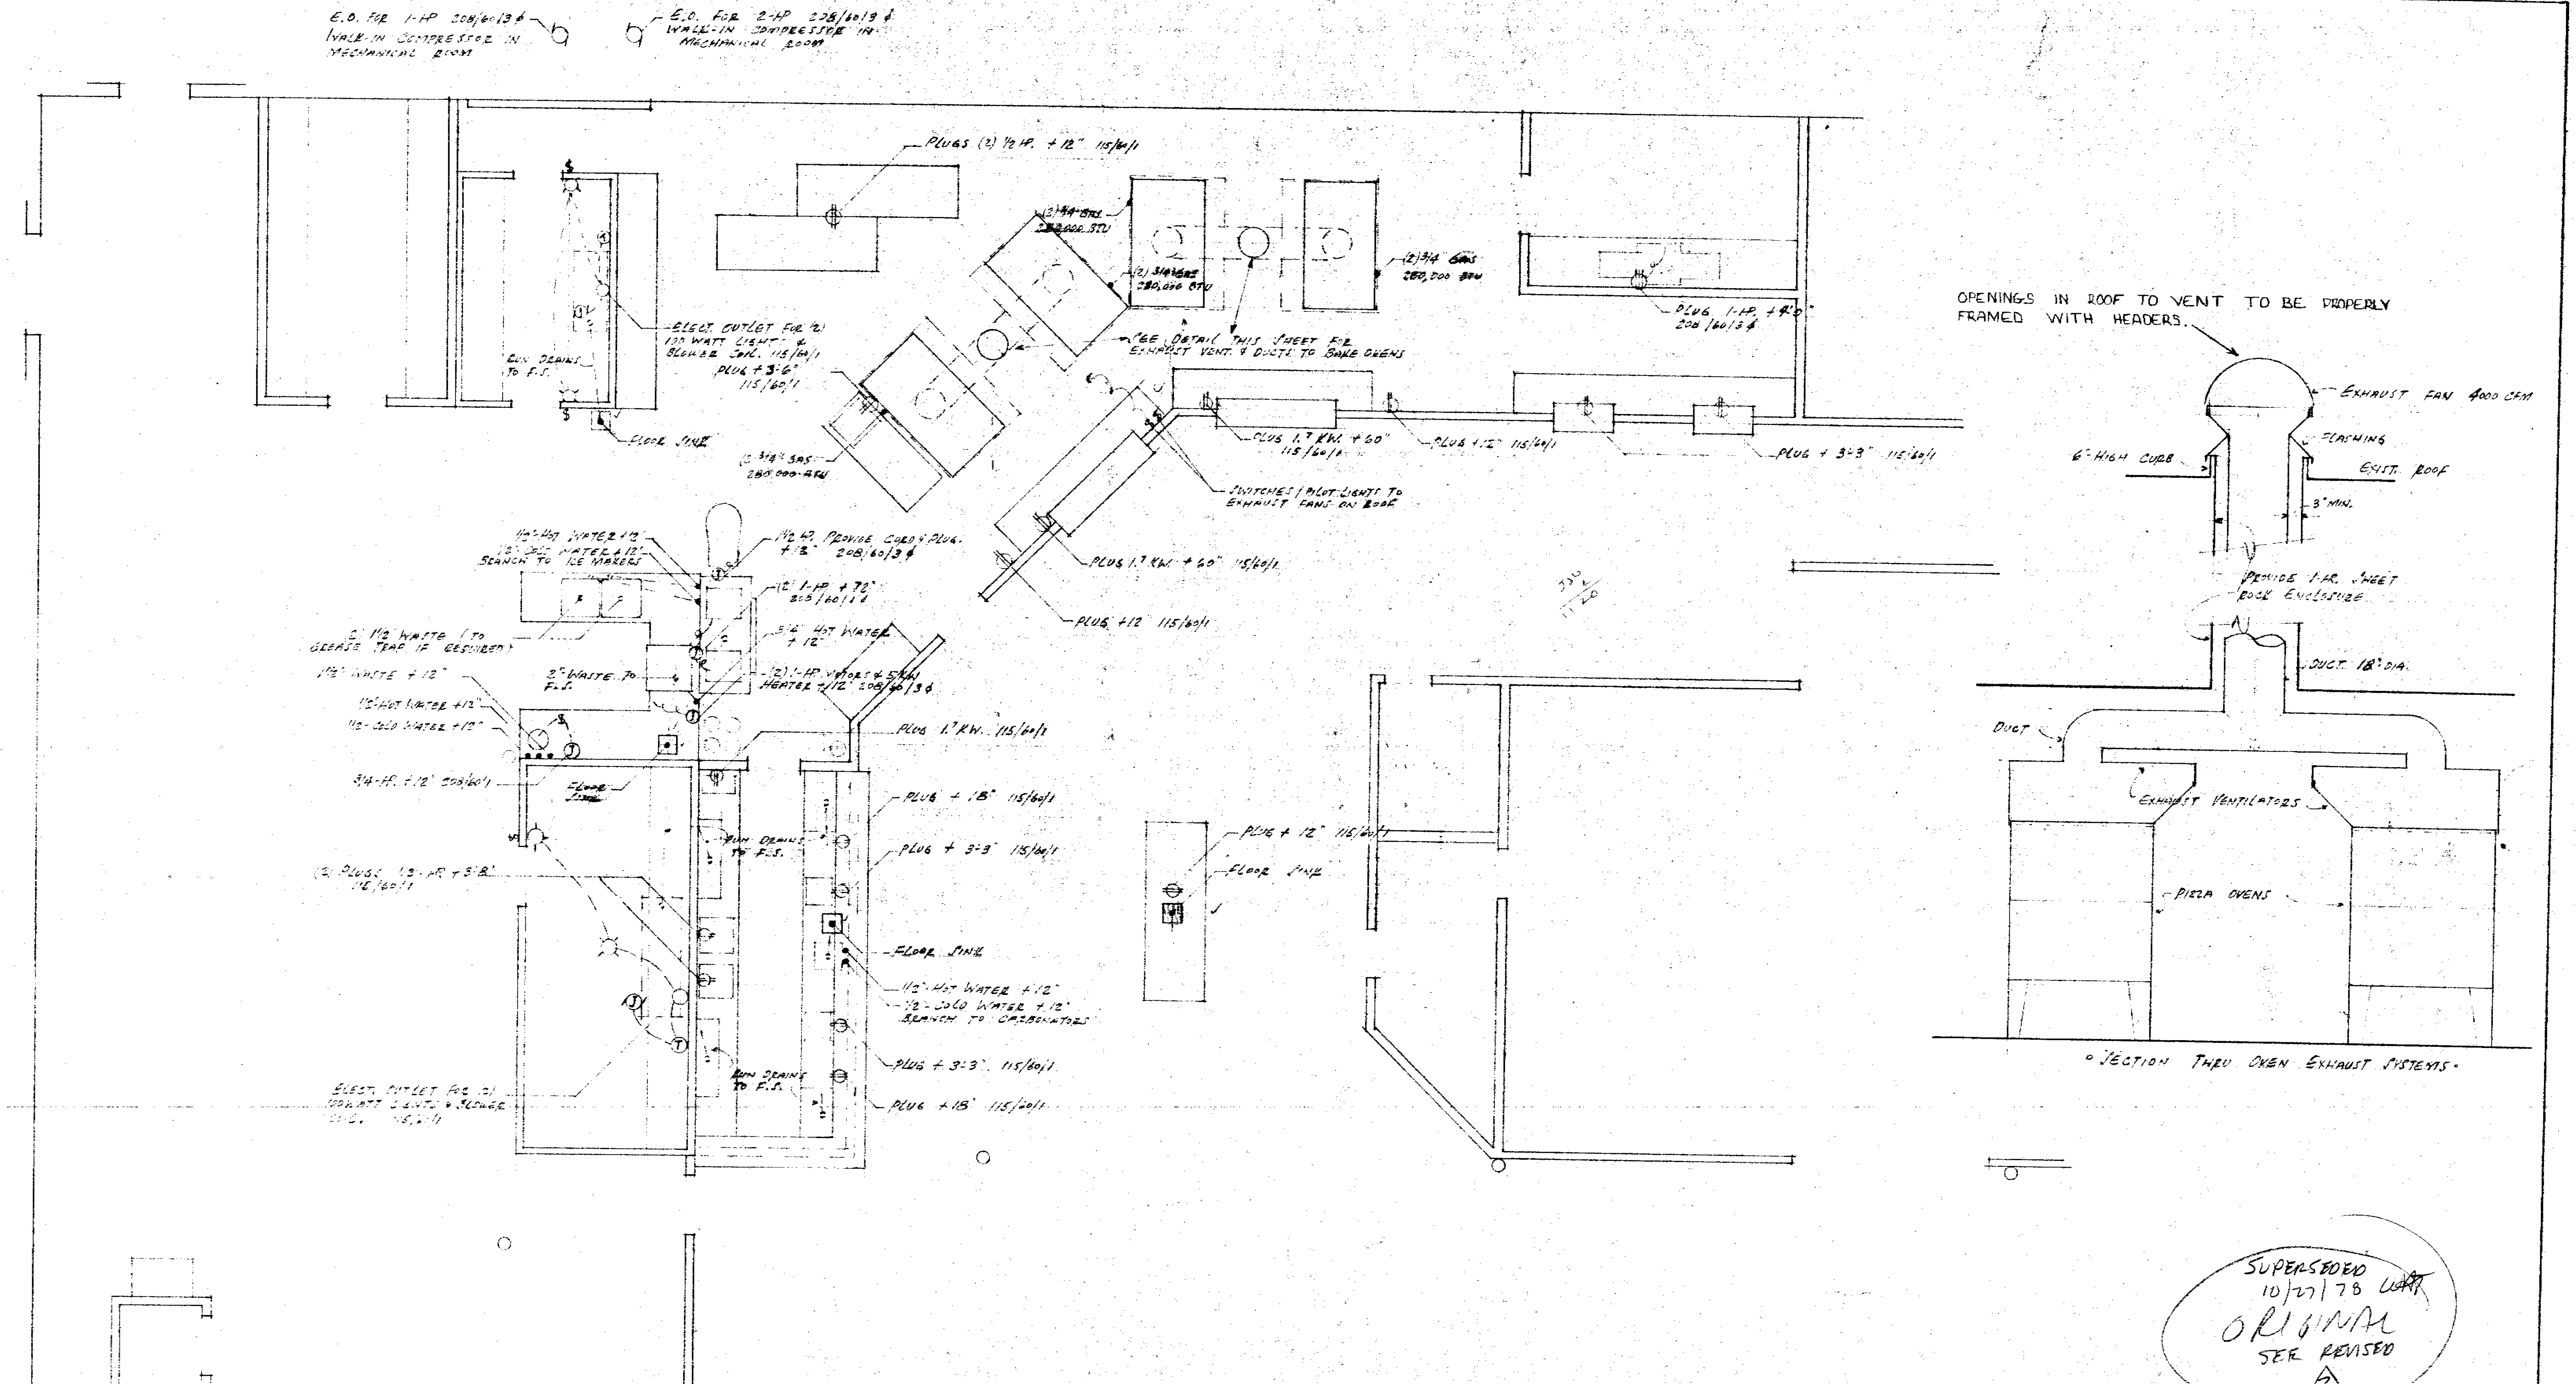
E.O. FOR 1-HP 208/60/3 ϕ WALK-IN COMPRESSOR IN MECHANICAL ROOM
E.O. FOR 2-HP 208/60/3 ϕ WALK-IN COMPRESSOR IN MECHANICAL ROOM
PLUGS (2) ½ HP. + 12" 115/60/1
(2) 3/4 GAS 280,000 BTU
(2) 3/4 GAS 280,000 BTU
(2) 3/4 GAS 280,000 BTU
(2) 3/4 GAS 280,000 BTU
PLUG 1-HP. + 4'0" 208/60/3 ϕ
SEE DETAIL THIS SHEET FOR EXHAUST VENT. & DUCTS TO BAKE OVENS
ELECT. OUTLET FOR (2) 100 WATT LIGHTS & BLOWER COIL. 115/60/1
PLUG + 3'-6" 115/60/1
RUN DRAINS TO F.S.
FLOOR SINK
PLUG 1.7 KW. + 60" 115/60/1
PLUG + 12" 115/60/1
PLUG + 3'-3" 115/60/1
SWITCHES / PILOT LIGHTS TO EXHAUST FANS ON ROOF
PLUG 1.7 KW. + 60" 115/60/1
PLUG + 12 115/60/1
1½" HOT WATER + 12"
½" COLD WATER + 12" BRANCH TO ICE MAKERS
½ HP. PROVIDE CORD & PLUG. + 12" 208/60/3 ϕ
(2) 1-HP + 72" 208/60/1 ϕ
3/4" HOT WATER + 12"
(2) 1-HP. MOTORS & 5 KW HEATER + 12" 208/60/3 ϕ
2" 1½" WASTE (TO GREASE TRAP IF REQUIRED)
2" WASTE TO F.S.
1½" WASTE + 12"
½" HOT WATER + 12"
½" COLD WATER + 12"
3/4-HP. + 12" 208/60/1
FLOOR SINK
PLUG 1.7 KW. 115/60/1
PLUG + 18" 115/60/1
PLUG + 3'-3" 115/60/1
RUN DRAINS TO F.S.
FLOOR SINK
½" HOT WATER + 12"
½" COLD WATER + 12" BRANCH TO CARBONATORS
PLUG + 3'-3". 115/60/1
PLUG + 18" 115/60/1
(2) PLUGS 1/3 - HP + 3'-8" 115/60/1
RUN DRAINS TO F.S.
ELECT. OUTLET FOR (2) 100 WATT LIGHTS & BLOWER COIL. 115/60/1
PLUG + 12" 115/60/1
FLOOR SINK
OPENINGS IN ROOF TO VENT TO BE PROPERLY FRAMED WITH HEADERS.
EXHAUST FAN 4000 CFM
FLASHING
6" HIGH CURB
EXIST. ROOF
3" MIN.
PROVIDE 1-HR. SHEET ROCK ENCLOSURE
DUCT 18" DIA.
DUCT
EXHAUST VENTILATORS
PIZZA OVENS
SECTION THRU OVEN EXHAUST SYSTEMS

MECHANICAL, ELECTRICAL & PLUMBING FOR FOOD SERVICE EQUIPMENT

SUPERSEDED
10/27/78
ORIGINAL
SEE REVISED
2

10

PIZZA TIME THEATRE
SAN JOSE, CA.
BY
DESIGN SERVICES
MENLO PARK CA.

12341

SHEET No. 3

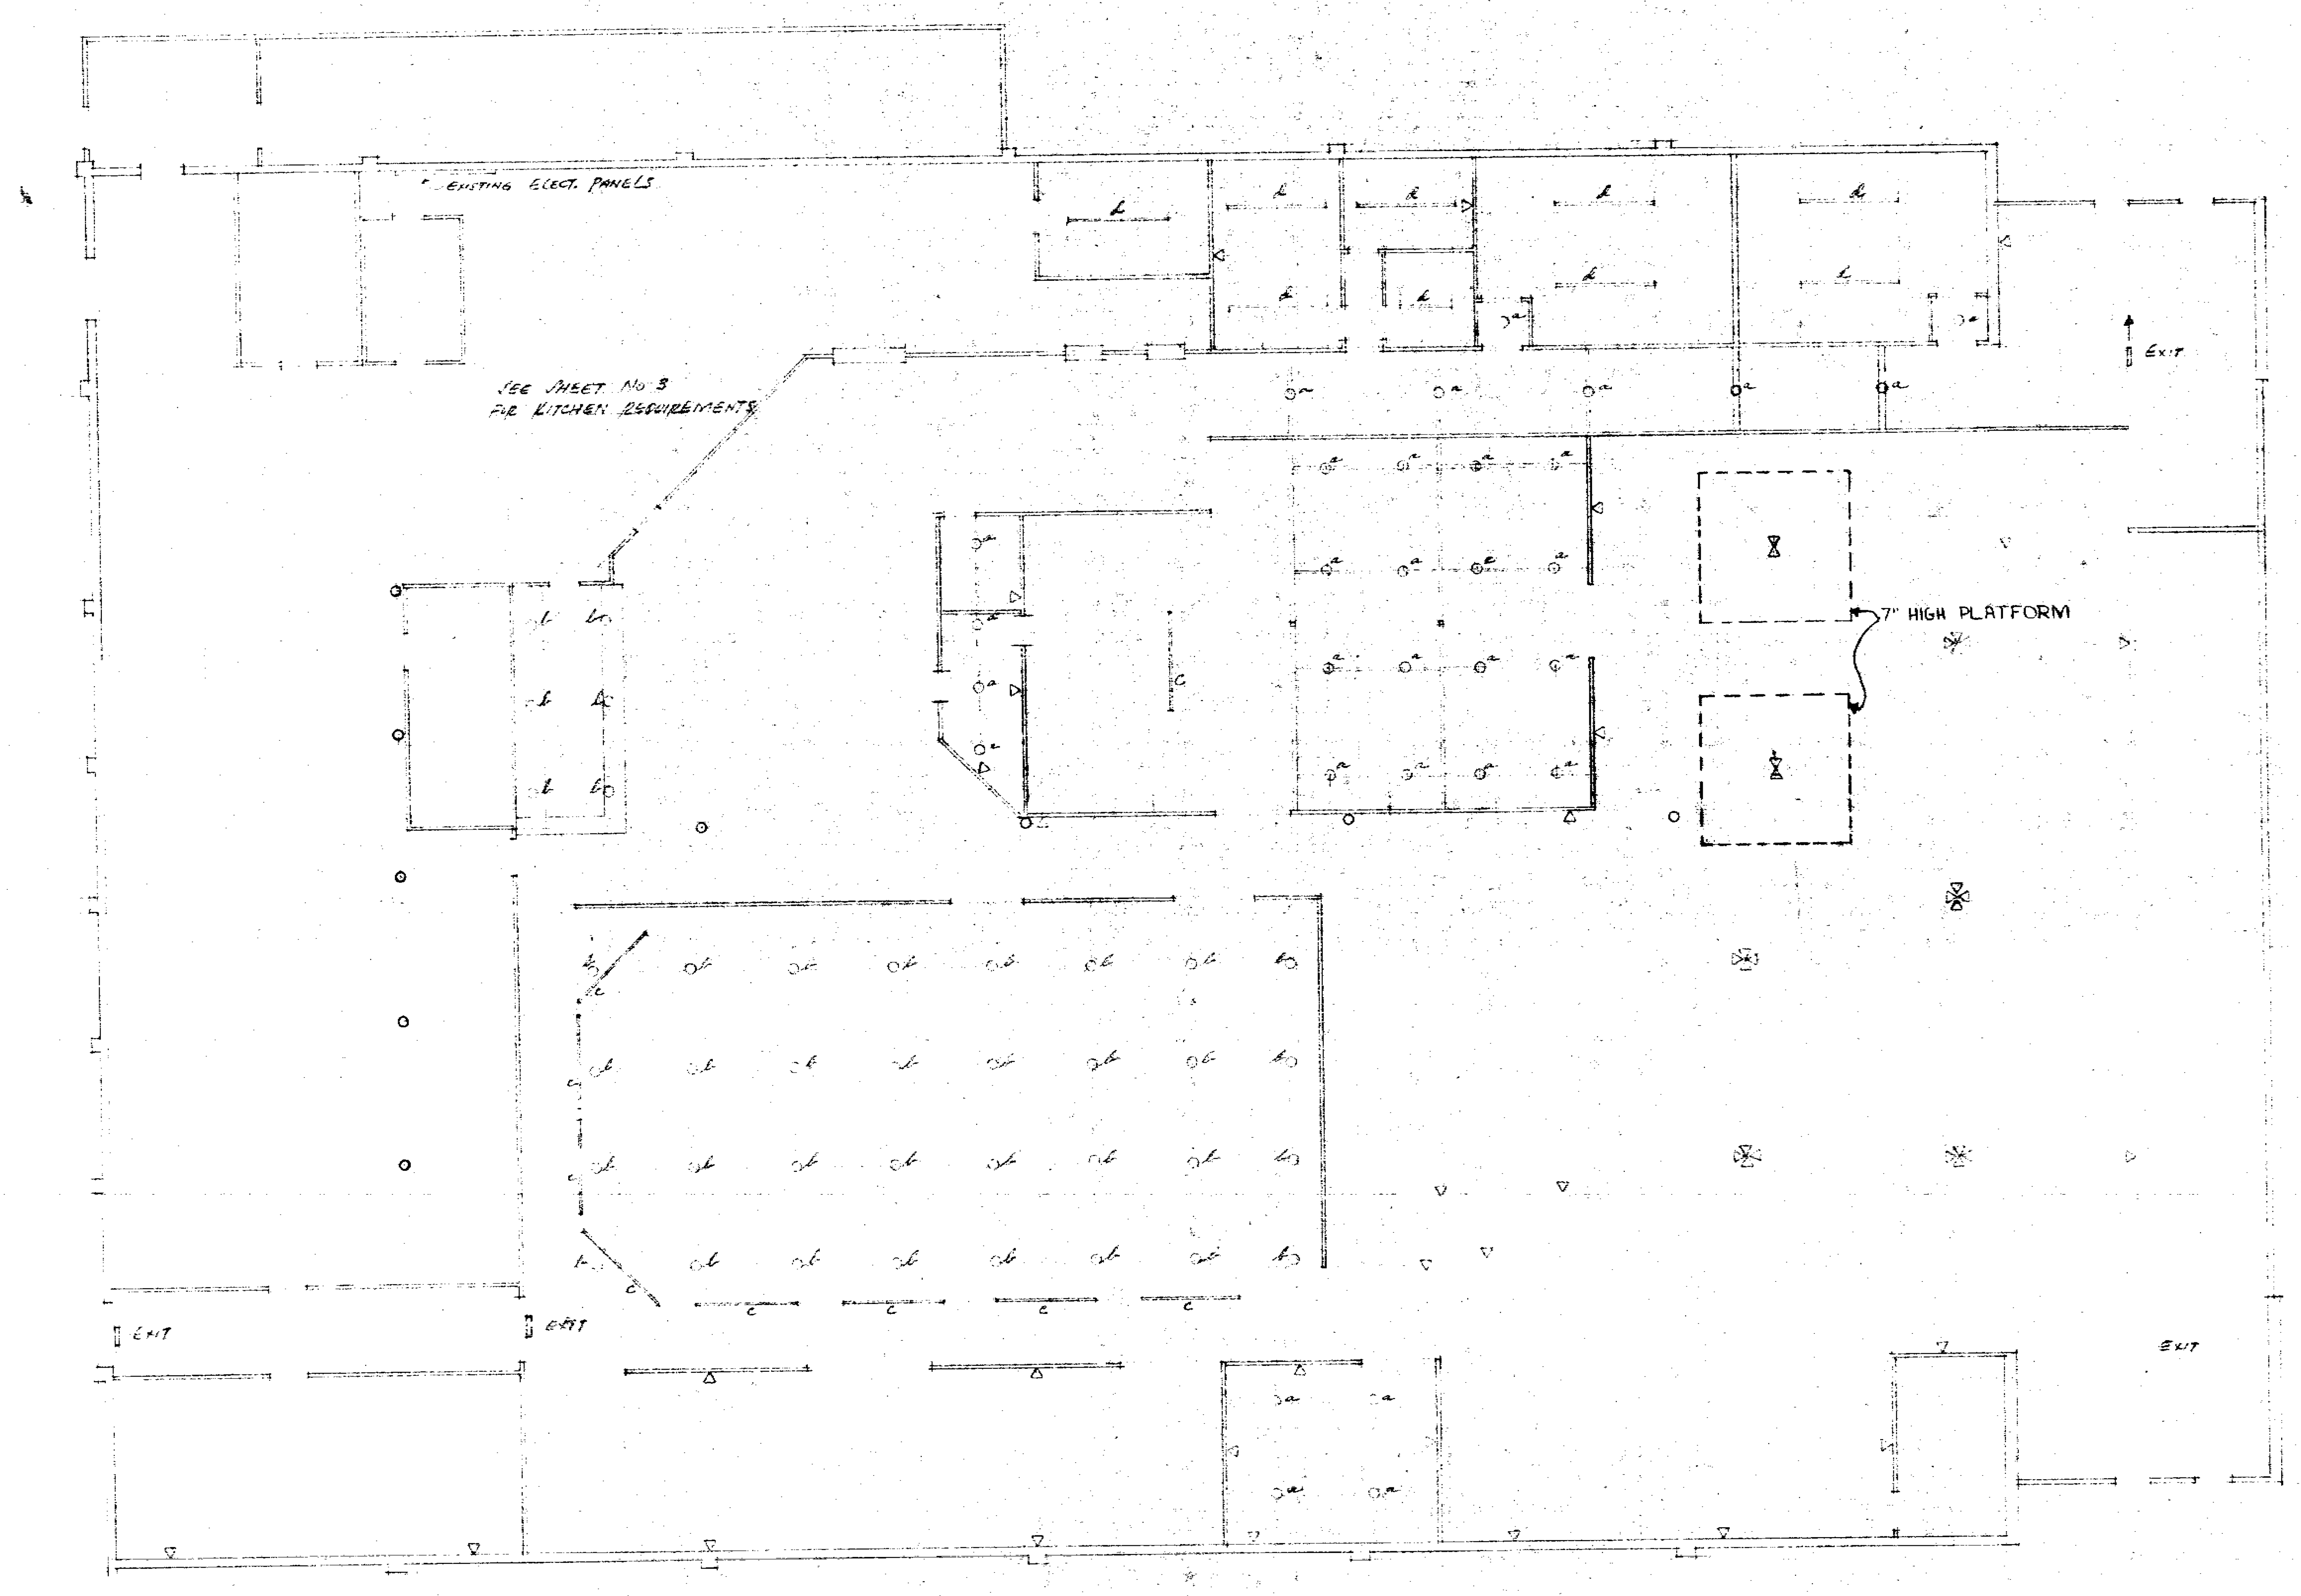

FIXTURE SCHEDULE

a. HALO H-2313 SURFACE MOUNT CYLINDER, 75 WATT R-30 LAMPS
b. SAME AS a EXCEPT TO BE HUNG AT 12'-0' WITH TUBULAR SUPPORT HANGERS.
c. LIGHTOLIER TWO CIRCUIT TRACK LIGHTS HUNG AT 12'-0', 4'-0" LONG RUN TO INDIVIDUAL SWITCHES PROVIDE (24) LIGHTS.
d. SURFACE MOUNT (2) LIGHT FLOURESCANT FIXTURES, SWITCH TO PANEL.

▽ WHERE SHOWN PROVIDE 20 AMP, 115/60/1Ø PLUG OUTLET, IN WALLS AT +12". IN FLOOR PROVIDE FLUSH [illegible] COVER.

PROVIDE EXIT & EMERGENCY LIGHTS AS REQUIRED BY FIRE MARSHALL

EXITING LIGHTING TO REMAIN FOR ALL AREAS. RELAMP AS DIRECTED BY OWNER.

SUPERSEDED
10/27/78 WAT
ORIGINAL
SEE REVISED 2

11

REFLECTED CEILING PLAN
1/8" = 1'-0"

PIZZA TIME THEATRE
SAN JOSE, CA.

BY
DESIGN SERVICES
MENLO PARK, CA.

12341

SHEET No. 4

	SQ FT.	SEATS	PARKING
THEATRE DINNING	2048	152	60.8
ADULT DINNING	1254	67	26.8
PRIVATE DINNING	840	40	16.0
TOTAL	4142	259	103.6

WOMENS:
PROVIDE (5) WATER CLOSETS, (3) LAVATORIES, MIRRORS, SOAP DISPENSERS, TOWEL DISPENSERS. ONE TOILET ENCLOSURE TO HAVE 2'-8" DOOR & GRAB BARS.
MEN'S
PROVIDE (2) WATER CLOSETS, (3) URINALS, (3) LAVATORIES, MIRRORS SOAP DISP., TOWEL DISPENSERS. ONE TOILET ENCLOSURE TO HAVE 2'-8" DOOR & GRAB BARS.

HANDICAPED REQUIREMENTS TO BE U.B.C. 1711.

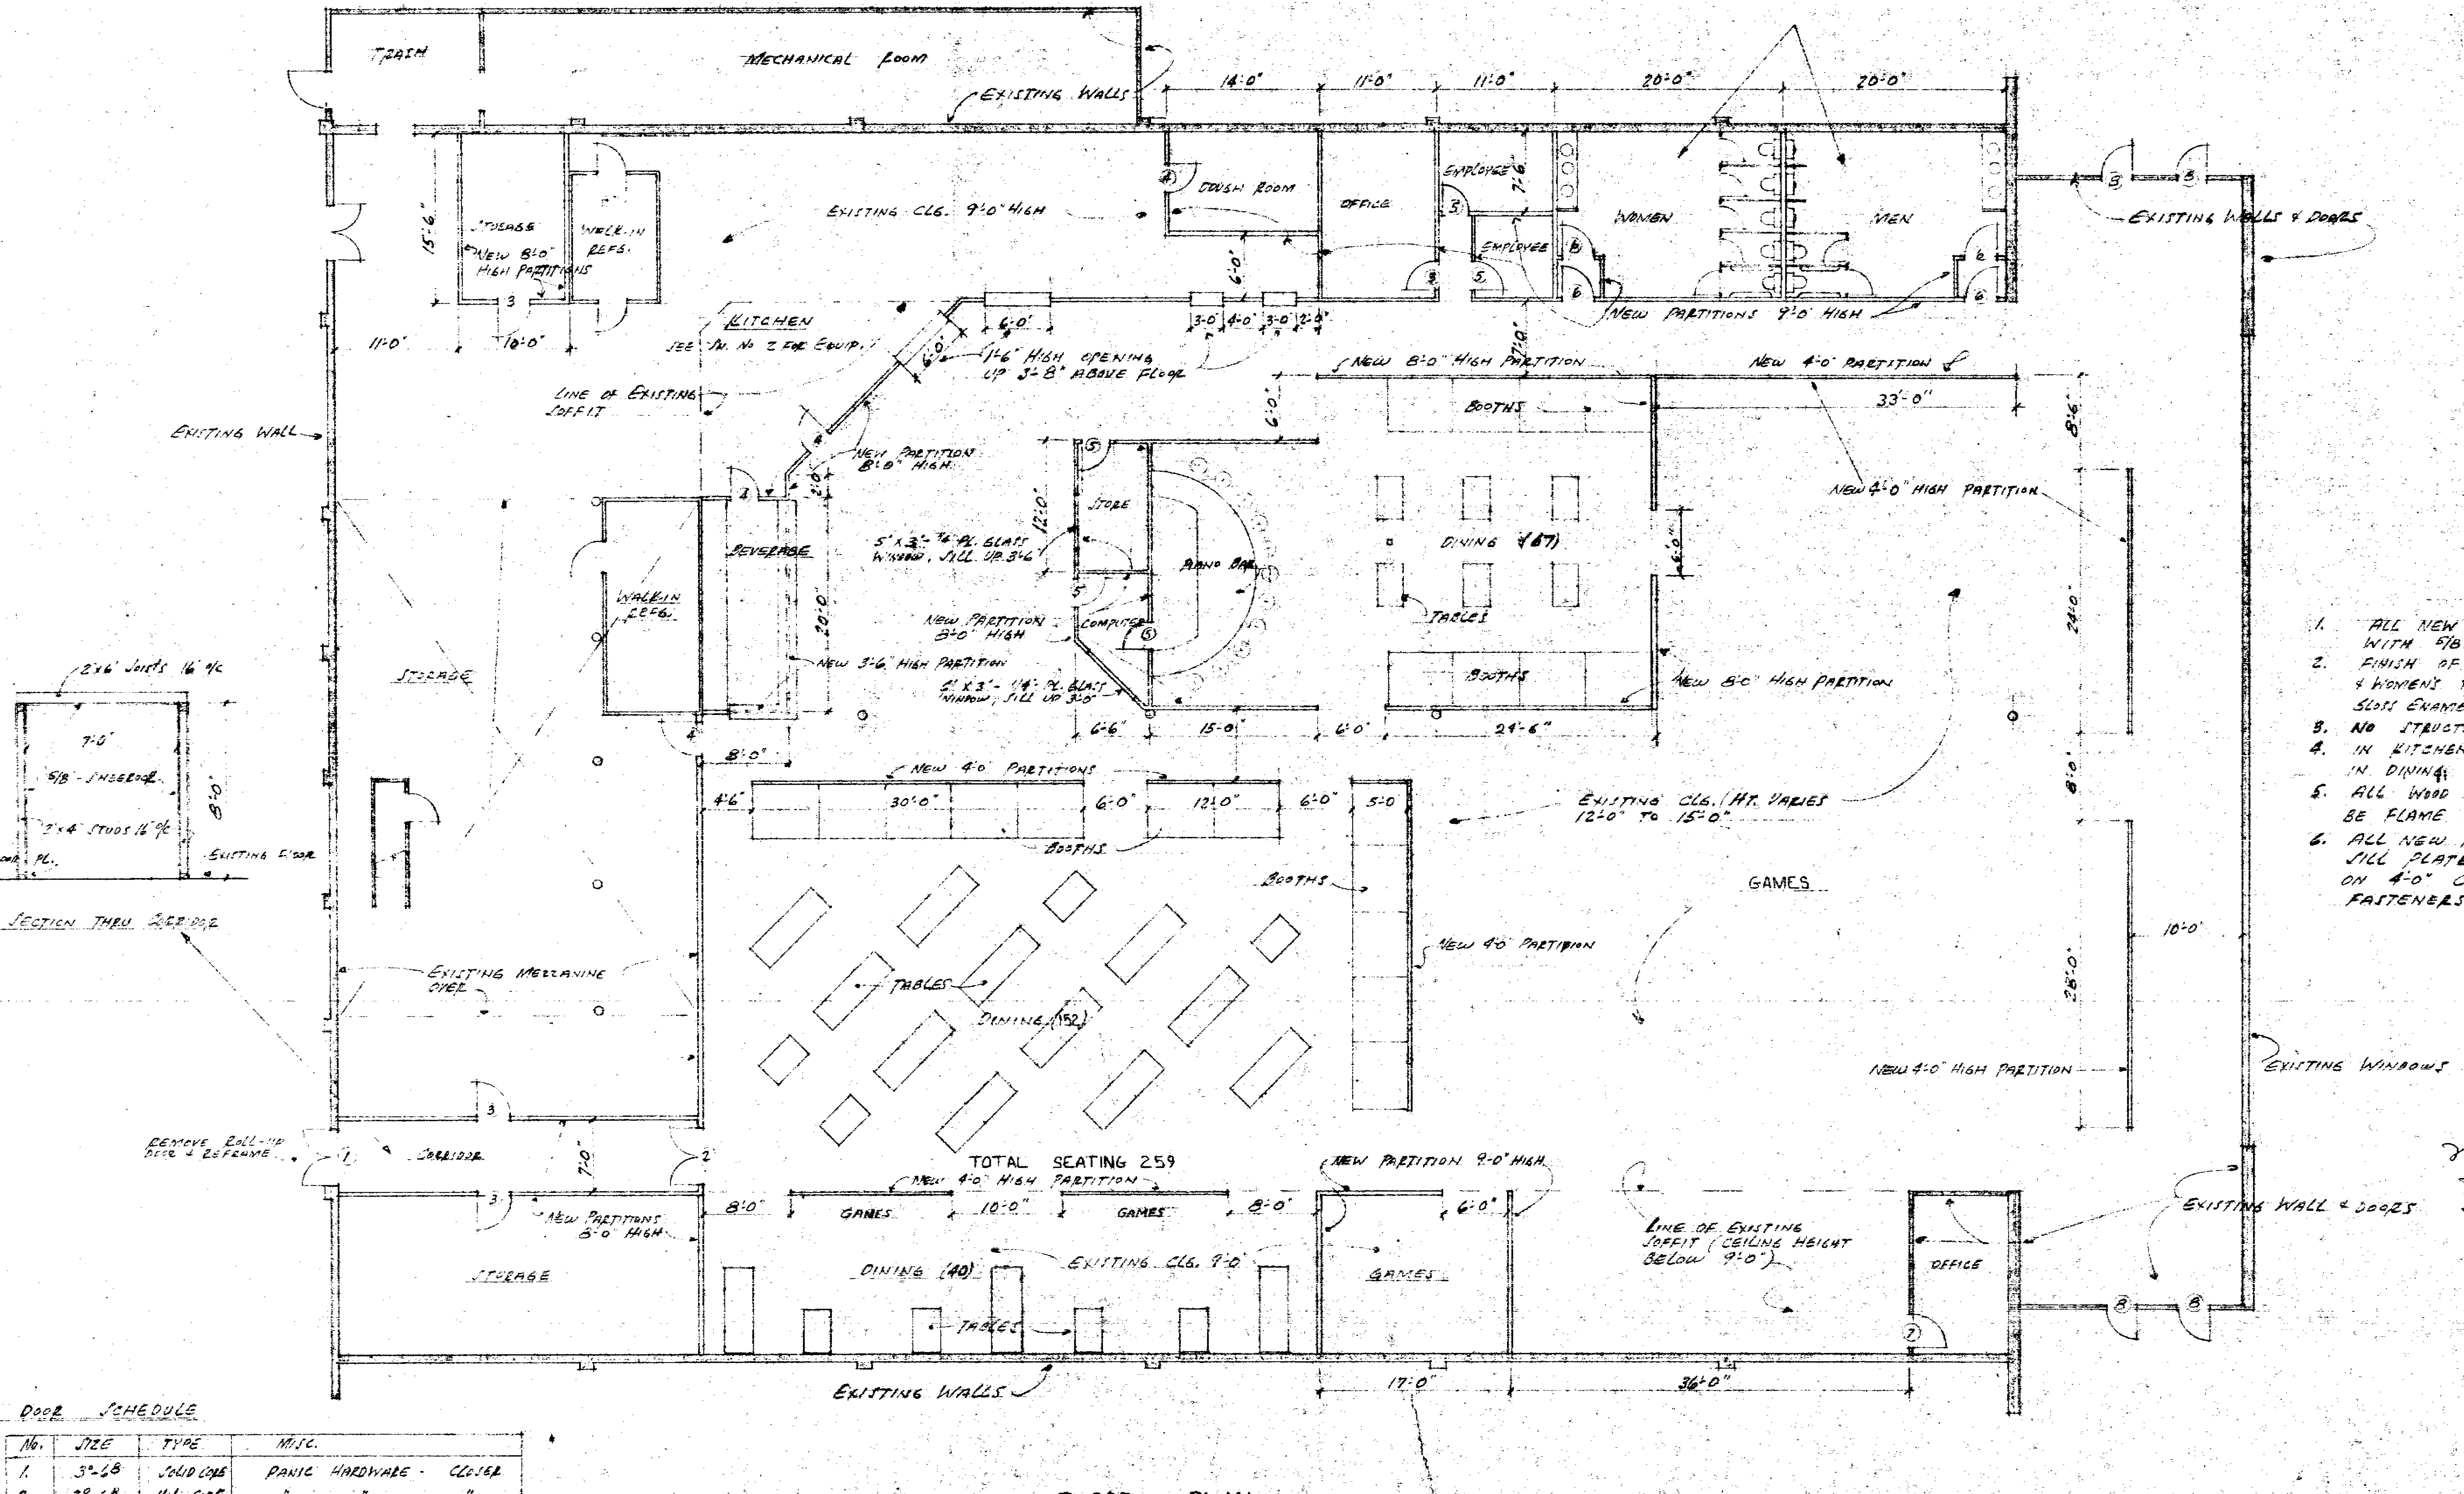

FLOOR PLAN
1/8" = 1'-0"

NOTES
1. ALL NEW PARTITIONS TO BE 2"×4 @ 16" O/C WITH 5/8" SHEET ROCK BOTH SIDES.
2. FINISH OF KITCHEN, DOUGH ROOM, STORAGE, MEN'S & WOMEN'S TOILETS TO BE TWO (2) COATS SEMI-GLOSS ENAMEL; LIGHT COLOR.
3. NO STRUCTURAL CHANGES ARE TO BE MADE.
4. IN KITCHEN PROVIDE (2) 20-B-C FIRE EXTINGUSHERS IN DINING PROVIDE (2) 2-A-10B-C FIRE EXTINGUSHERS.
5. ALL WOOD PANELING OR DECORATIVE MATERIALS SHALL BE FLAME TREATED.
6. ALL NEW PARTITIONS TO HAVE 2"×4" REDWOOD SILL PLATE ANCHORED TO CONCRETE SLAB ON 4'-0" CENTERS WITH HILTI OR EQUAL FASTENERS.

Date 8-23-78 No.
APPROVED as submitted
as corrected X
ENVIRONMENTAL MANAGEMENT AGENCY
ENVIRONMENTAL HEALTH SERVICES
By Edward W. Smith, R.S.

Note:
The exhaust fans for hoods must be sufficient to draw 4200 cfm's
EWS

DOOR SCHEDULE

No.	SIZE	TYPE	MISC.
1.	3°-6⁸	SOLID CORE	PANIC HARDWARE - CLOSER
2.	3°-6⁸	HOL. CORE	" " "
3.	3°-6⁸	SOLID CORE	DEAD BOLT LOCK
4.	3°-6⁸	HOL. CORE	NO LOCKS - CLOSER
5.	3°-6⁸	HOL. CORE	DEAD BOLT LOCK
6.	2⁰-6⁸	HOL. CORE	CLOSER
7.	EXISTING		ADD DEAD BOLT LOCK
8.	"		ADD PANIC HARDWARE

ALL DOOR UNLISTED ARE EXISTING WITH NO CHANGES

PAID
8-1-79
R# 111759

12

12341

PIZZA TIME THEATRE, INC
~~SAN JOSE,~~ CA.
SITE: 1371 KOOSER Rd. San Jose CA
BY:
DESIGN SERVICES
MENLO PARK, CA.
PTT DNG. : Grey Tilden
968-3861
968-3866

SCALE: 1/8" = 1'-0"
SHEET NO. 1

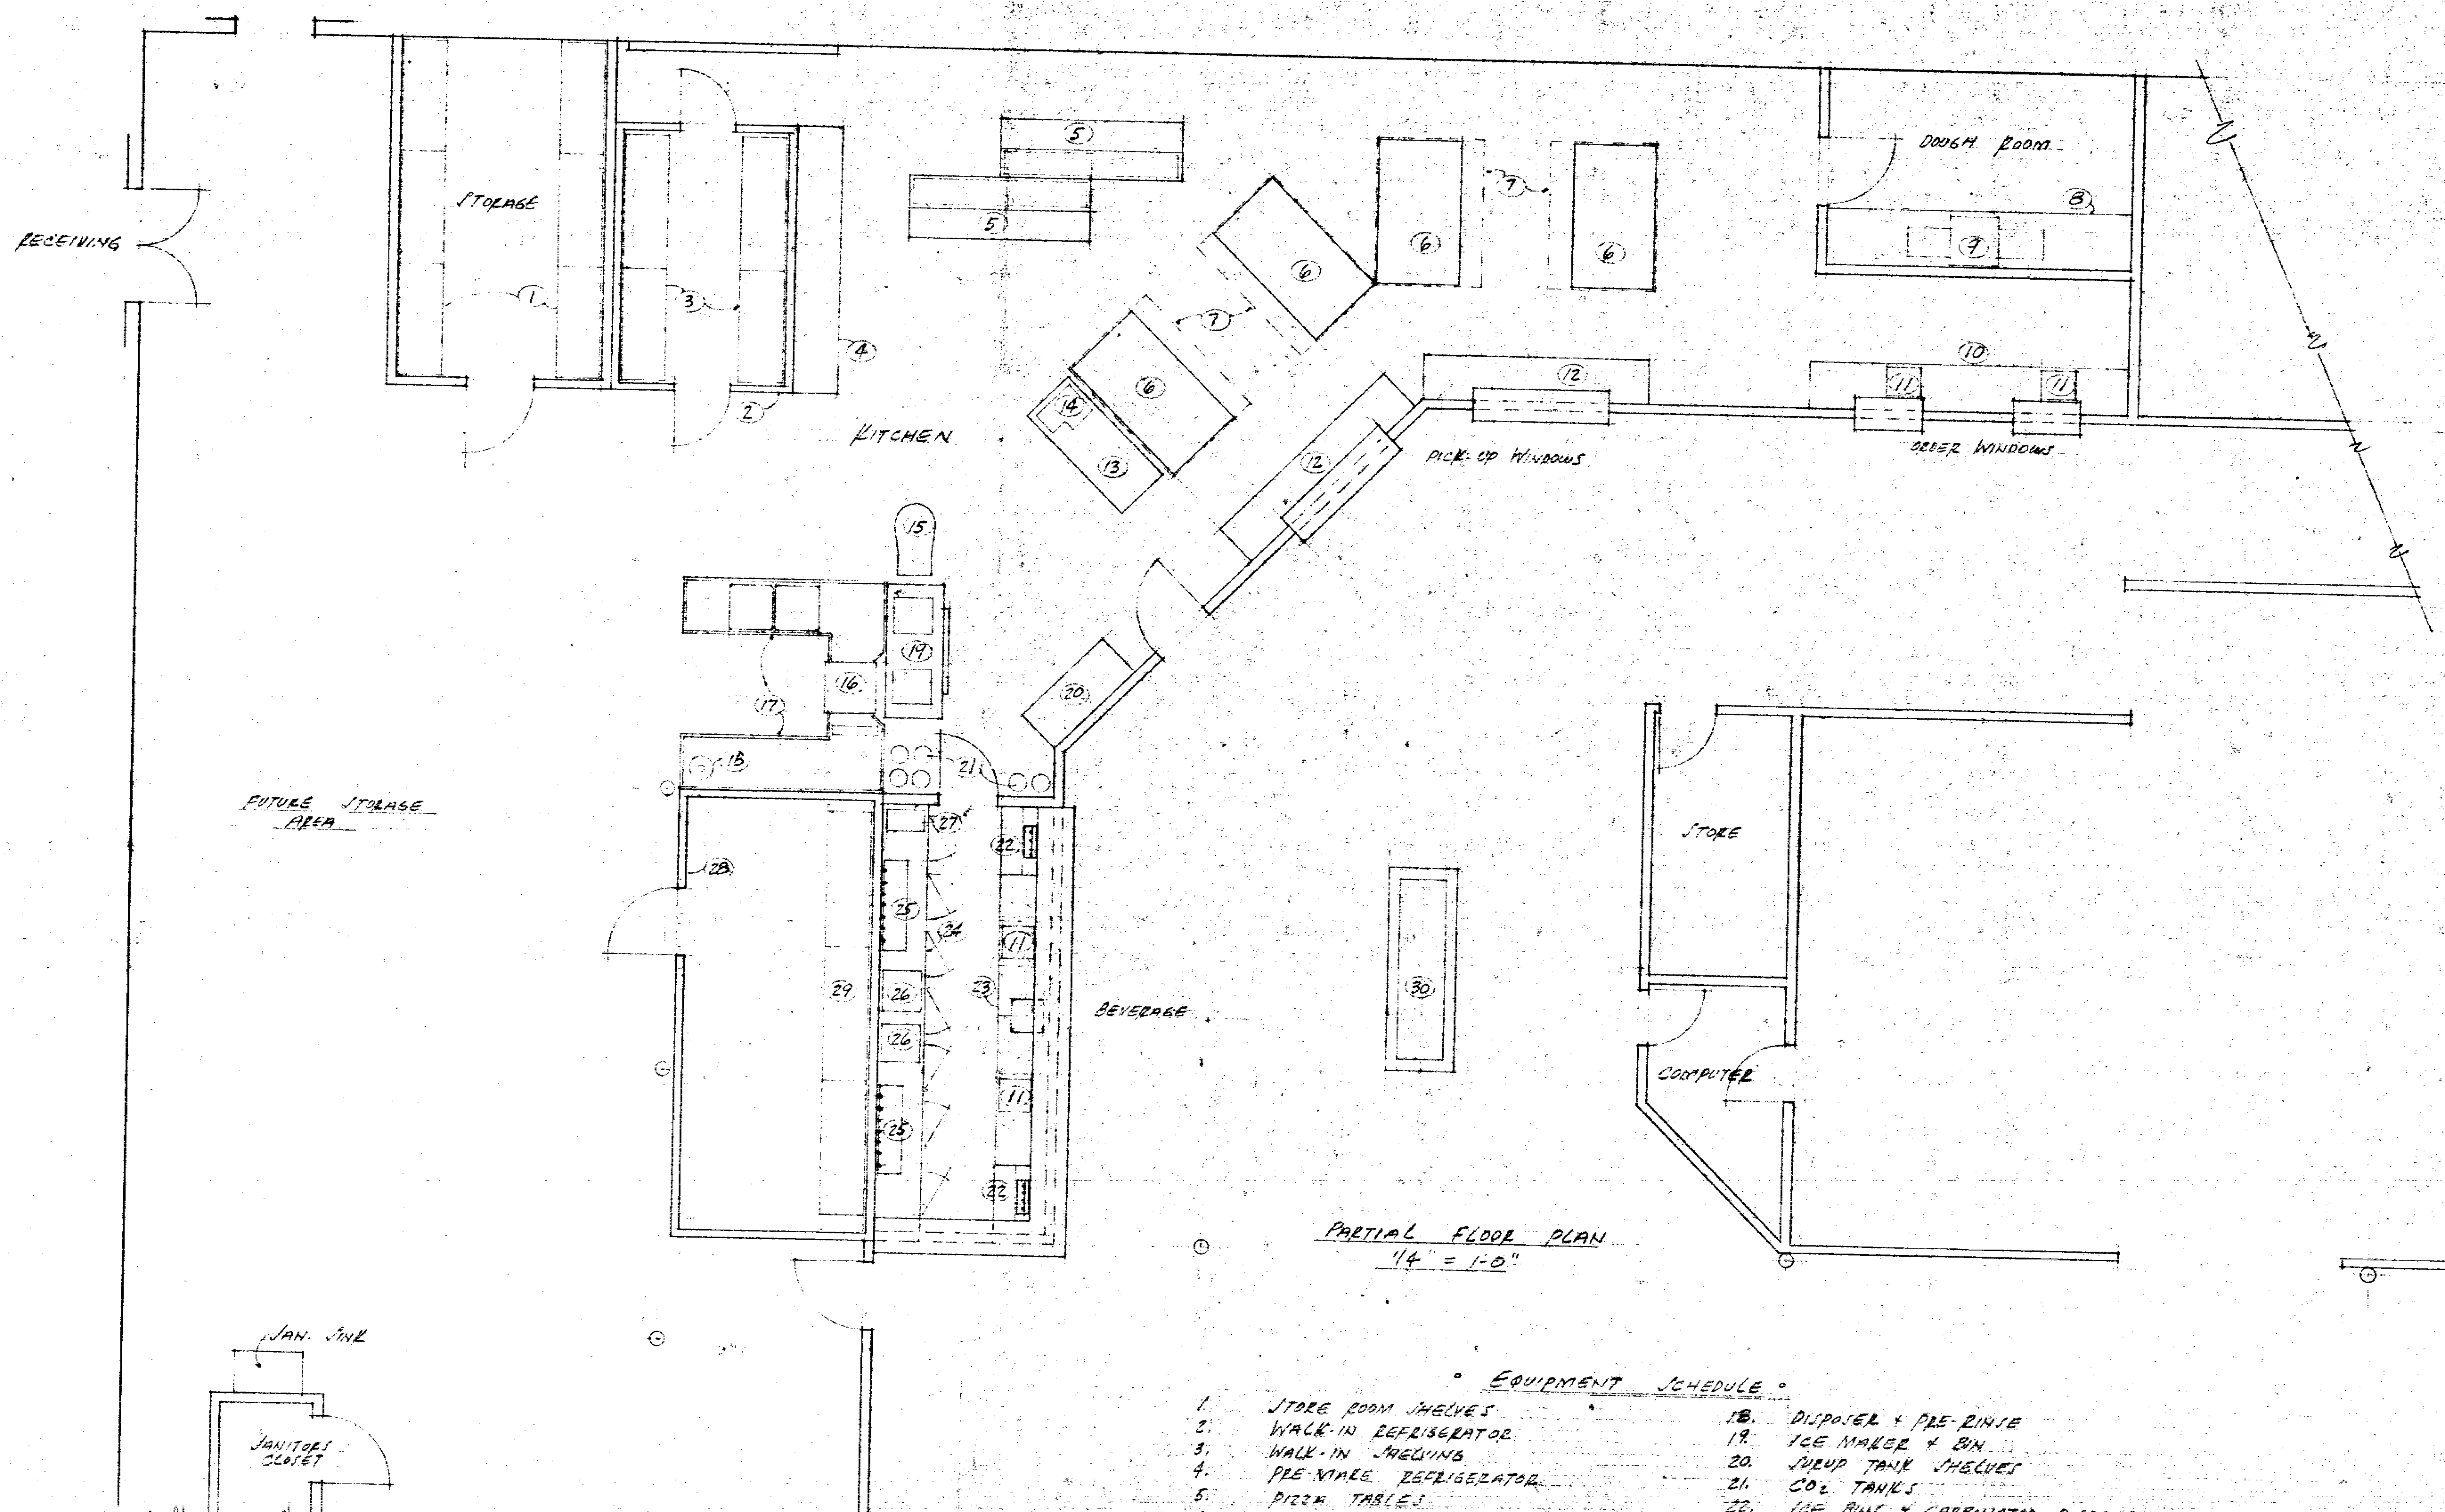

PARTIAL FLOOR PLAN
1/4" = 1'-0"

• EQUIPMENT SCHEDULE •

1. STORE ROOM SHELVES
2. WALK-IN REFRIGERATOR
3. WALK-IN SHELVING
4. PRE-MAKE REFRIGERATOR
5. PIZZA TABLES
6. PIZZA OVENS
7. EXHAUST VENTILATORS
8. DOUGH ROLLING TABLE
9. DOUGH ROLLER
10. ORDER COUNTER
11. CASH REGISTERS
12. PIZZA CUTTING TABLES
13. WORK TABLE
14. SLICER
15. MIXER
16. DISHWASHER
17. SOILED + CLEAN TABLES
18. DISPOSER + PRE-RINSE
19. ICE MAKER + BIN
20. SYRUP TANK SHELVES
21. CO2 TANKS
22. ICE BINS + CARBONATED DISPENSERS
23. COUNTER / SINK
24. BACK BAR REFRIGERATOR
25. BEER + WINE FAUCETS
26. YOGURT MACHINES
27. COFFEE MAKER
28. WALK-IN REFRIGERATOR
29. WALK-IN SHELVING
30. SALAD BAR

13

12341

PIZZA TIME THEATRE
SAN JOSE, CA.
BY
DESIGN SERVICES
MENLO PARK, CA.

SHEET No 2

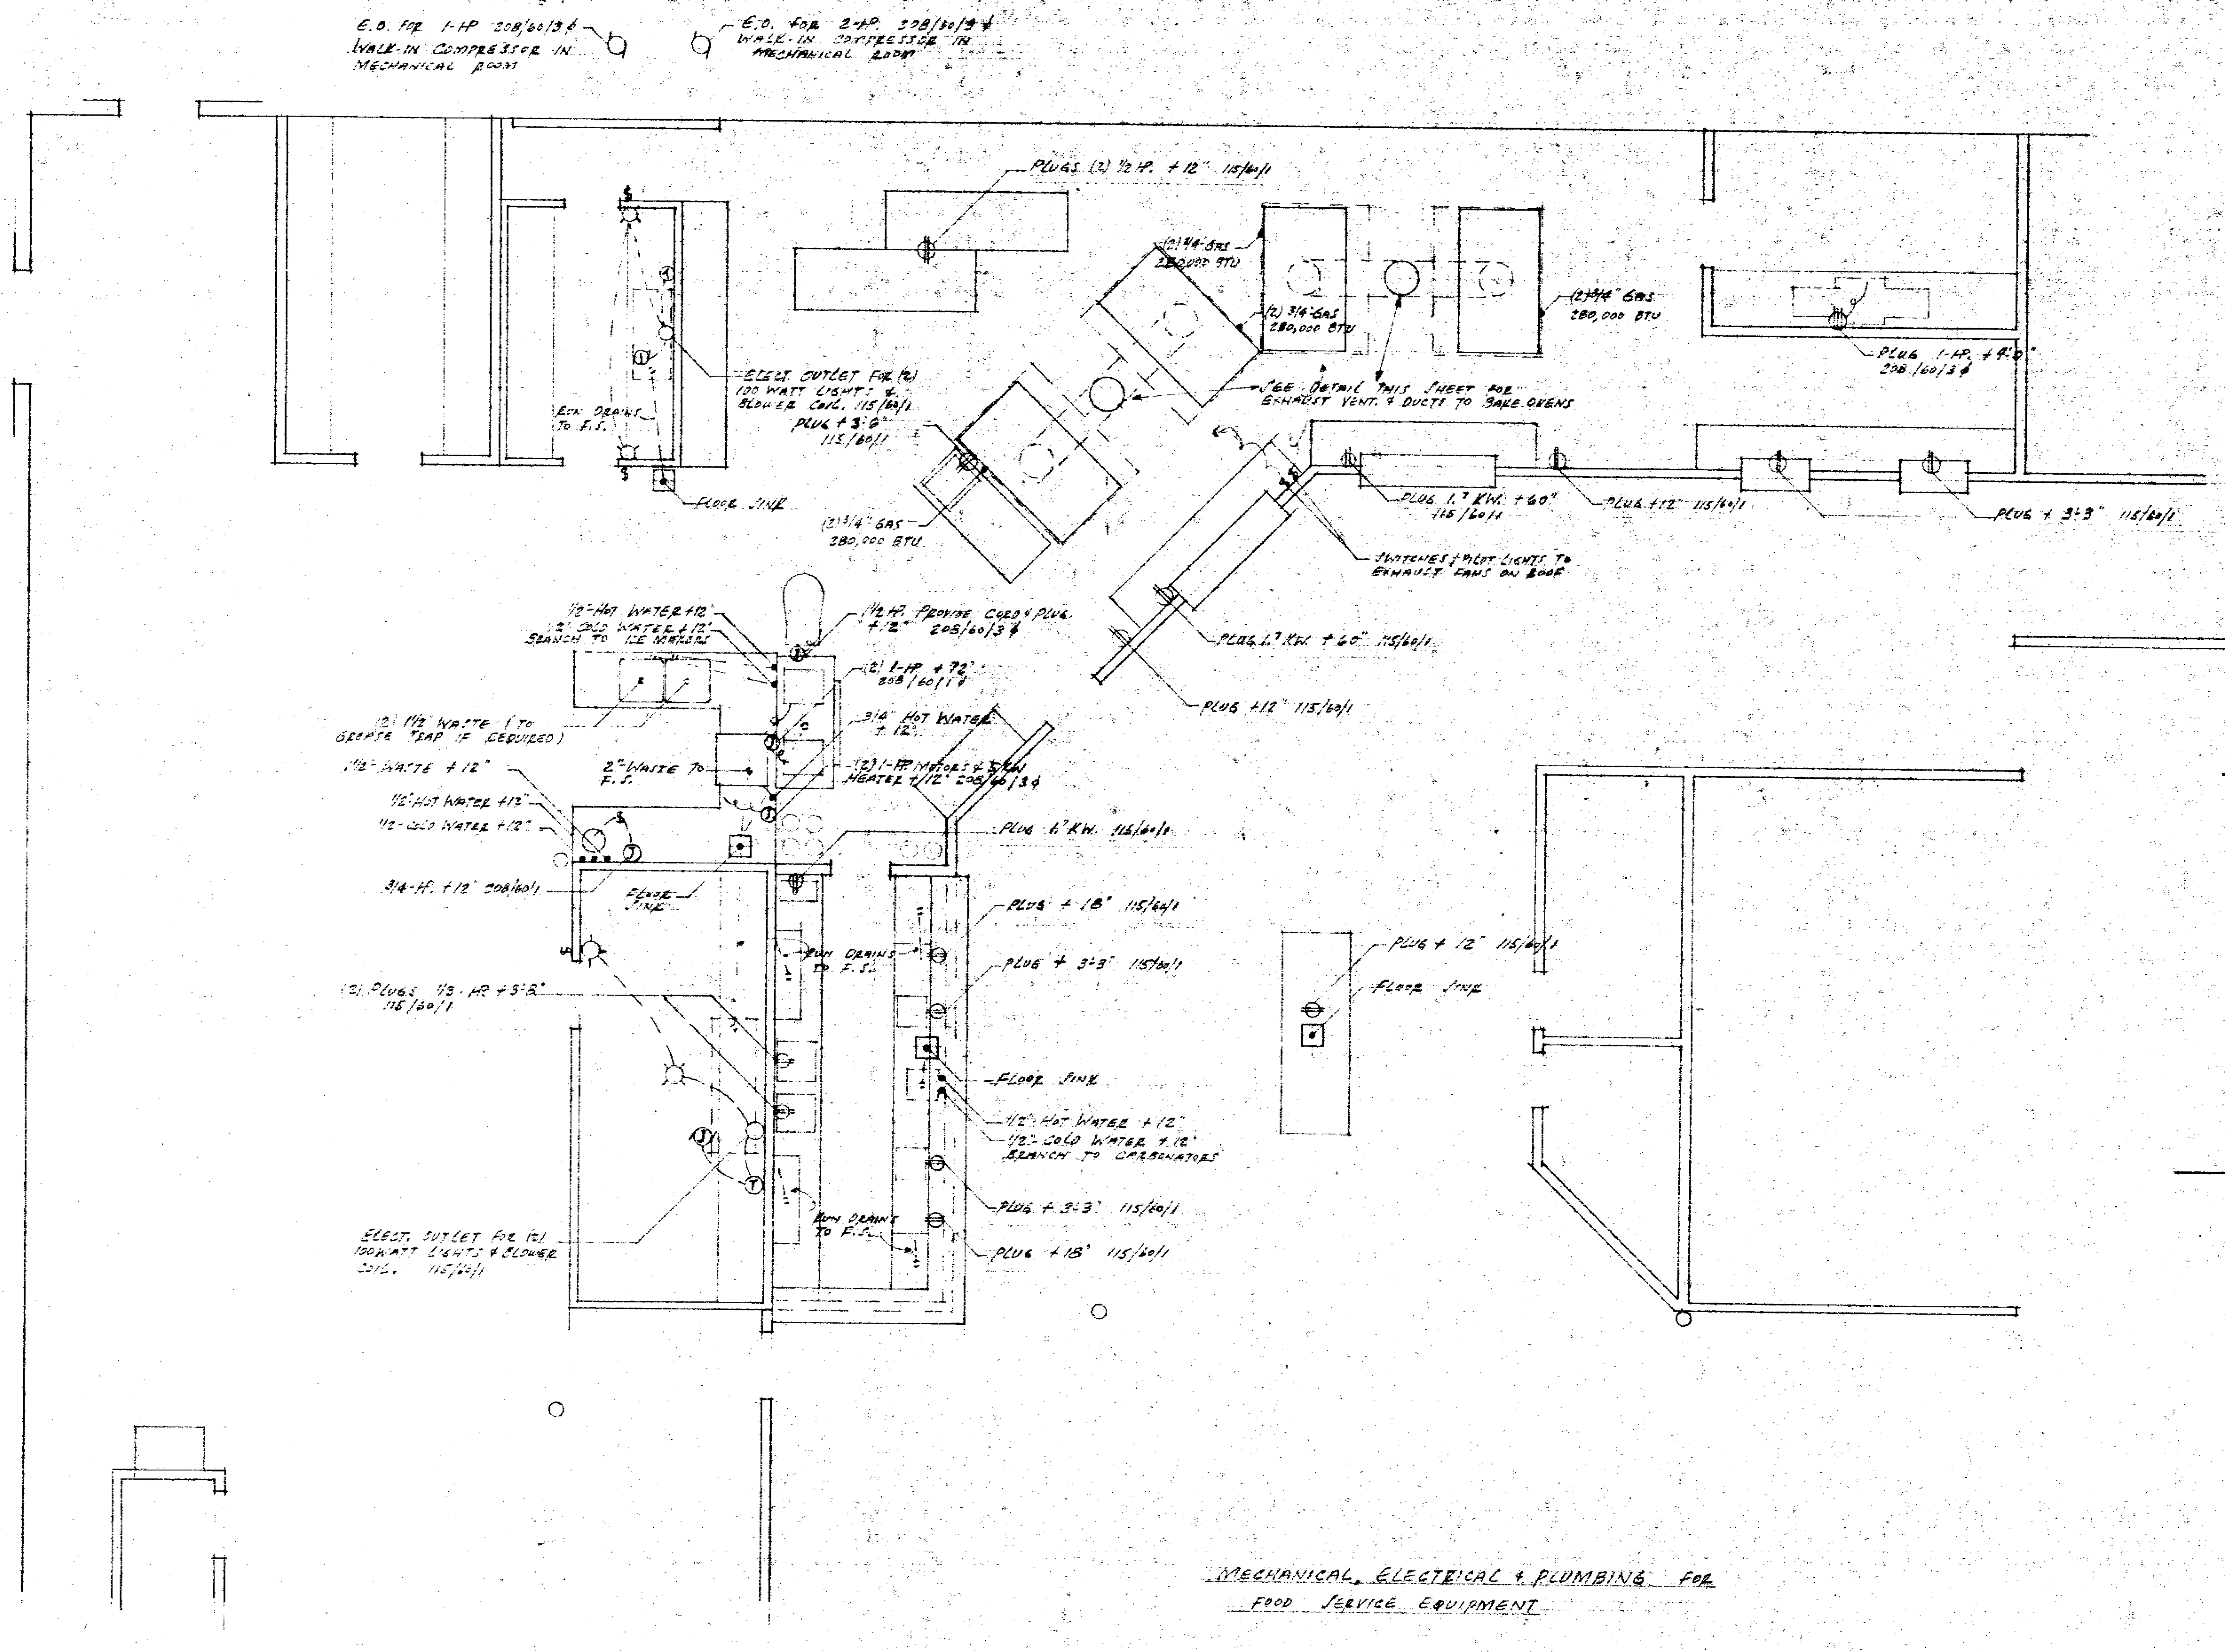
E.O. FOR 1-HP 208/60/3ϕ WALK-IN COMPRESSOR IN MECHANICAL ROOM
E.O. FOR 2-HP 208/60/3ϕ WALK-IN COMPRESSOR IN MECHANICAL ROOM
PLUGS (2) 1/2 HP. + 12" 115/60/1
(2) 3/4" GAS 280,000 BTU
(2) 3/4" GAS 280,000 BTU
(2) 3/4" GAS 280,000 BTU
(2) 3/4" GAS 280,000 BTU
ELECT. OUTLET FOR (2) 100 WATT LIGHTS & BLOWER COIL. 115/60/1
PLUG + 3'-6" 115/60/1
RUN DRAINS TO F.S.
FLOOR SINK
SEE DETAIL THIS SHEET FOR EXHAUST VENT. & DUCTS TO BAKE OVENS
PLUG 1-HP. + 4'-0" 208/60/3ϕ
PLUG 1.7 KW. + 60" 115/60/1
PLUG + 12" 115/60/1
PLUG + 3'-3" 115/60/1
SWITCHES & PILOT LIGHTS TO EXHAUST FANS ON ROOF
PLUG 1.7 KW. + 60" 115/60/1
PLUG + 12" 115/60/1
1/2" HOT WATER + 12"
1/2" COLD WATER + 12" BRANCH TO ICE MAKERS
1 1/2 HP. PROVIDE CORD & PLUG. + 12" 208/60/3ϕ
(2) 1-HP + 72" 208/60/1ϕ
3/4" HOT WATER + 12"
(2) 1-HP MOTORS & 5 KW HEATER + 12" 208/60/3ϕ
(2) 1 1/2" WASTE (TO GREASE TRAP IF REQUIRED)
1 1/2" WASTE + 12"
2" WASTE TO F.S.
1/2" HOT WATER + 12"
1/2" COLD WATER + 12"
3/4-HP. + 12" 208/60/1
FLOOR SINK
PLUG 1" KW. 115/60/1
PLUG + 18" 115/60/1
PLUG + 3'-3" 115/60/1
RUN DRAINS TO F.S.
FLOOR SINK
1/2" HOT WATER + 12"
1/2" COLD WATER + 12" BRANCH TO CARBONATORS
PLUG + 3'-3" 115/60/1
PLUG + 18" 115/60/1
RUN DRAINS TO F.S.
(2) PLUGS 1/3-HP + 3'-8" 115/60/1
ELECT. OUTLET FOR (2) 100 WATT LIGHTS & BLOWER COIL. 115/60/1
PLUG + 12" 115/60/1
FLOOR SINK

MECHANICAL, ELECTRICAL & PLUMBING FOR FOOD SERVICE EQUIPMENT

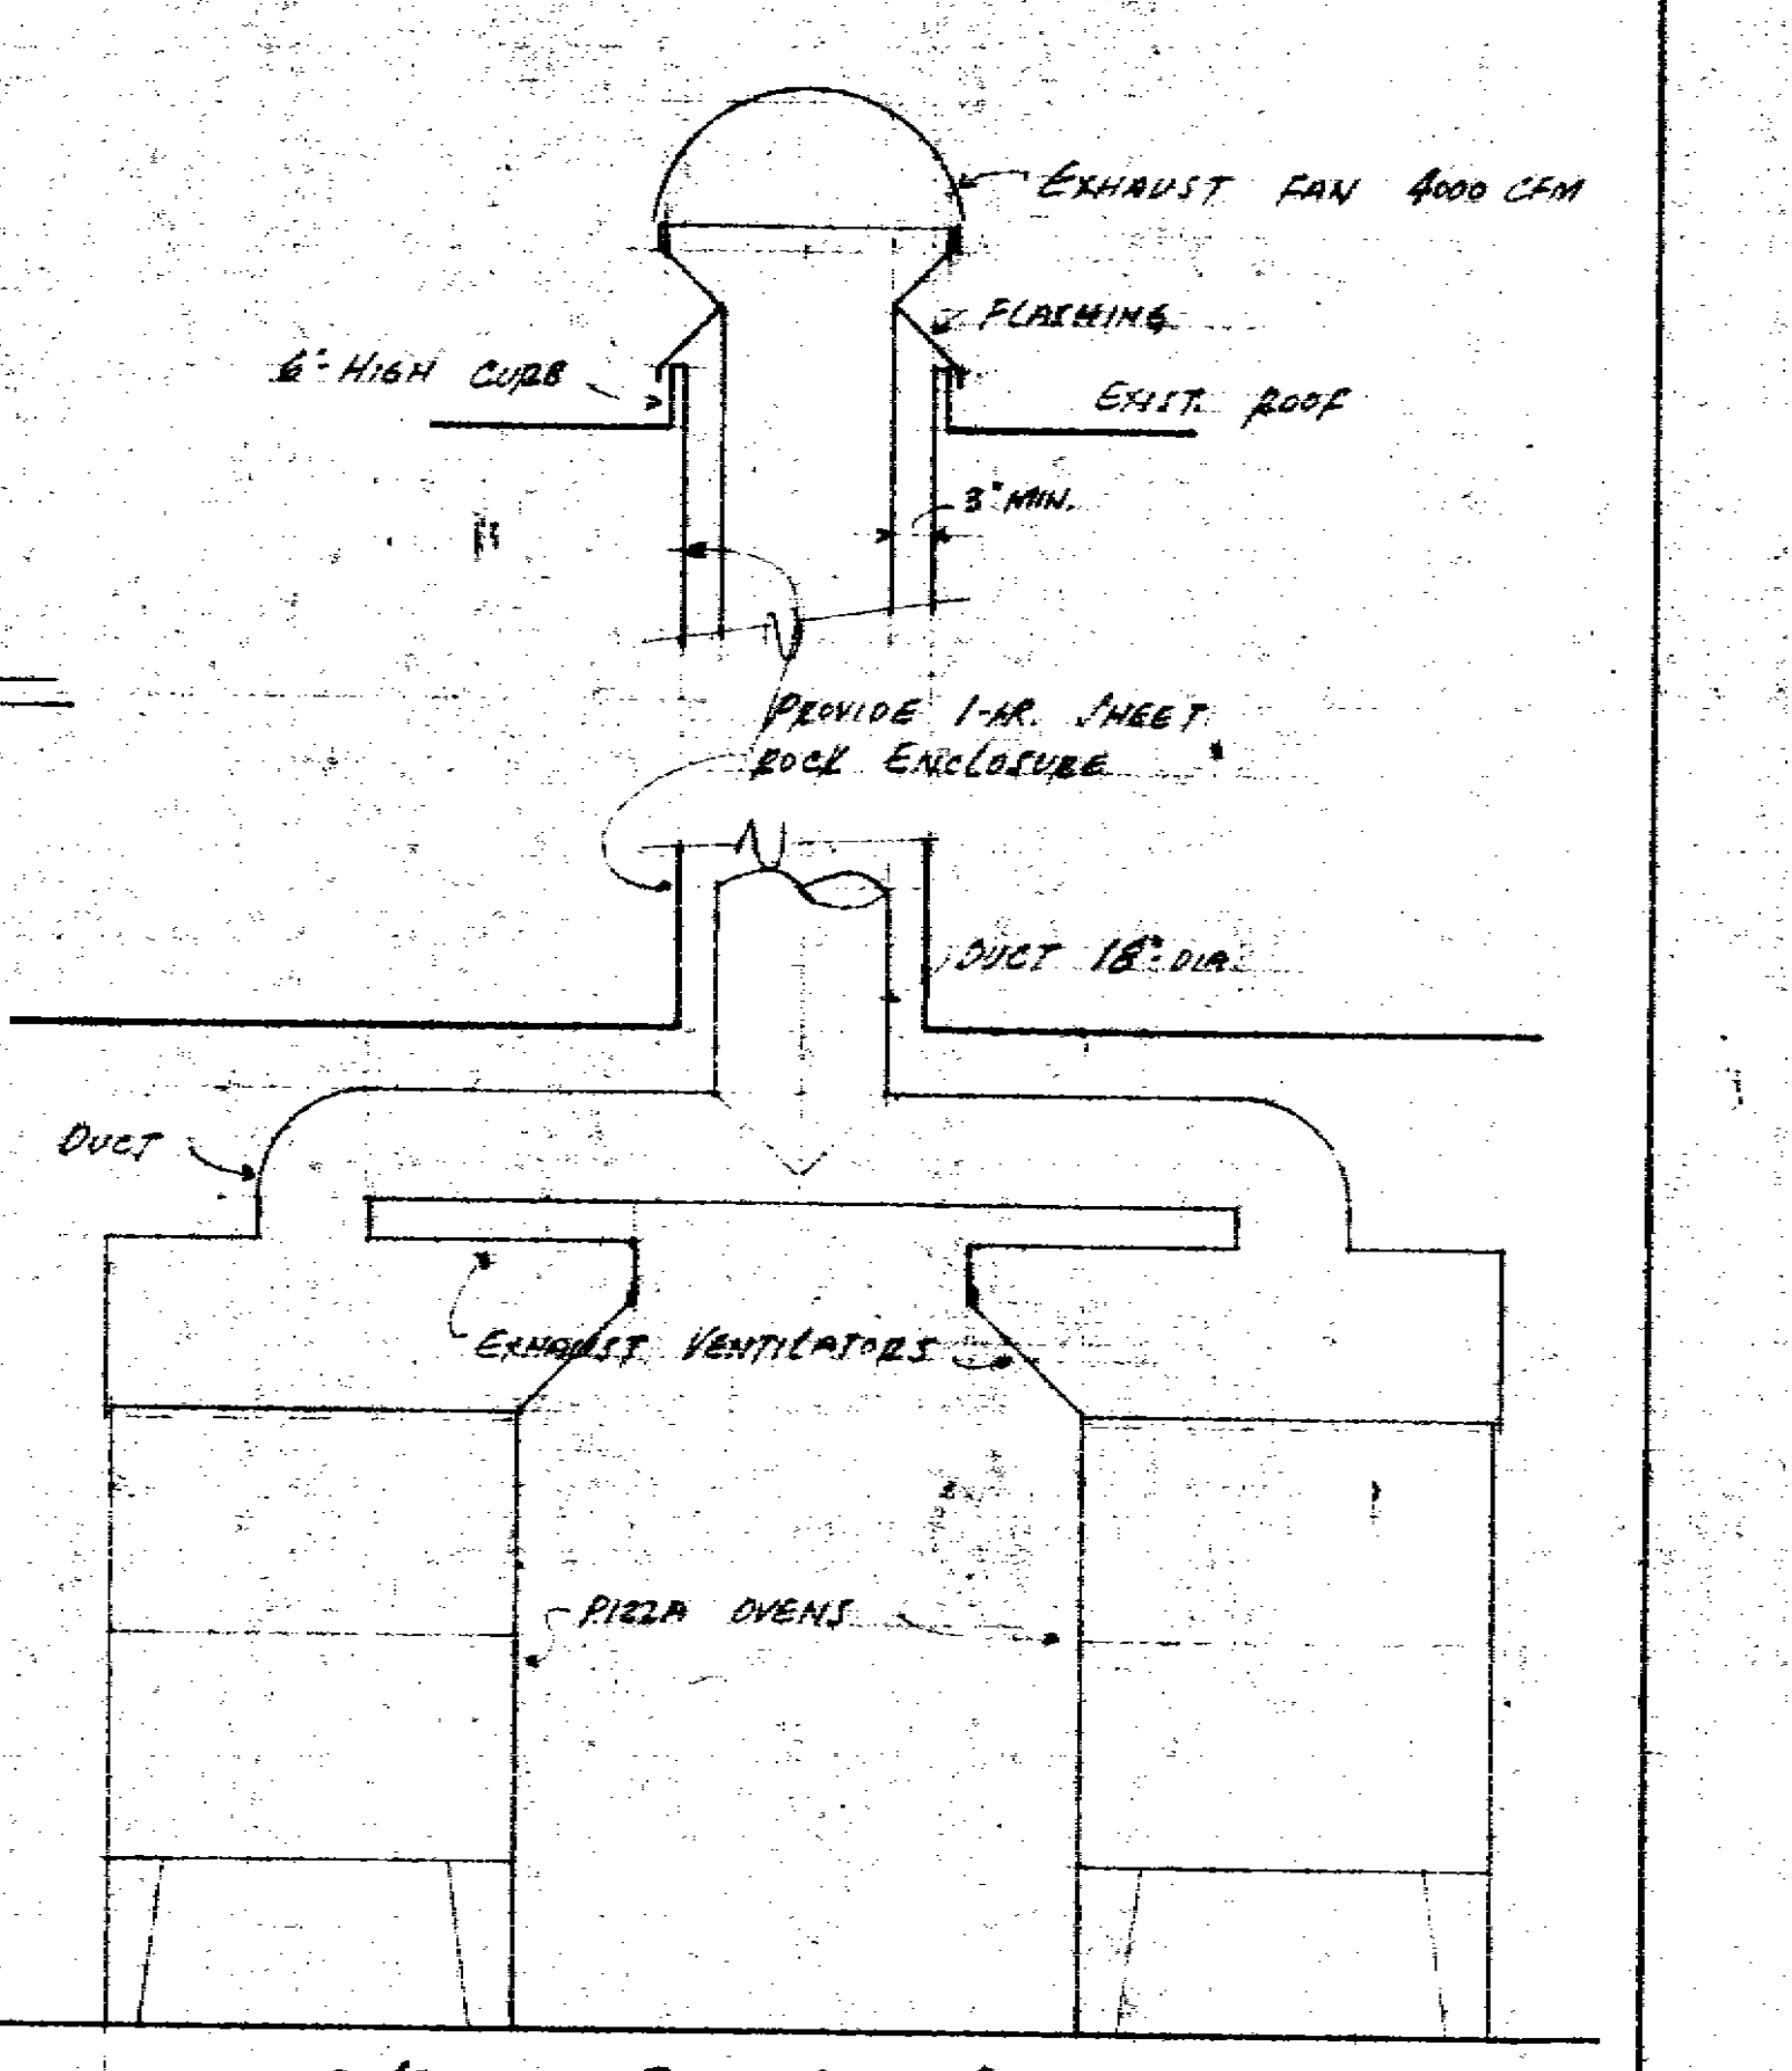

• SECTION THRU OVEN EXHAUST SYSTEMS •

14

12341

PIZZA TIME THEATRE
SAN JOSE, CA.
BY
DESIGN SERVICES
MENLO PARK, CA.

SHEET No. 3

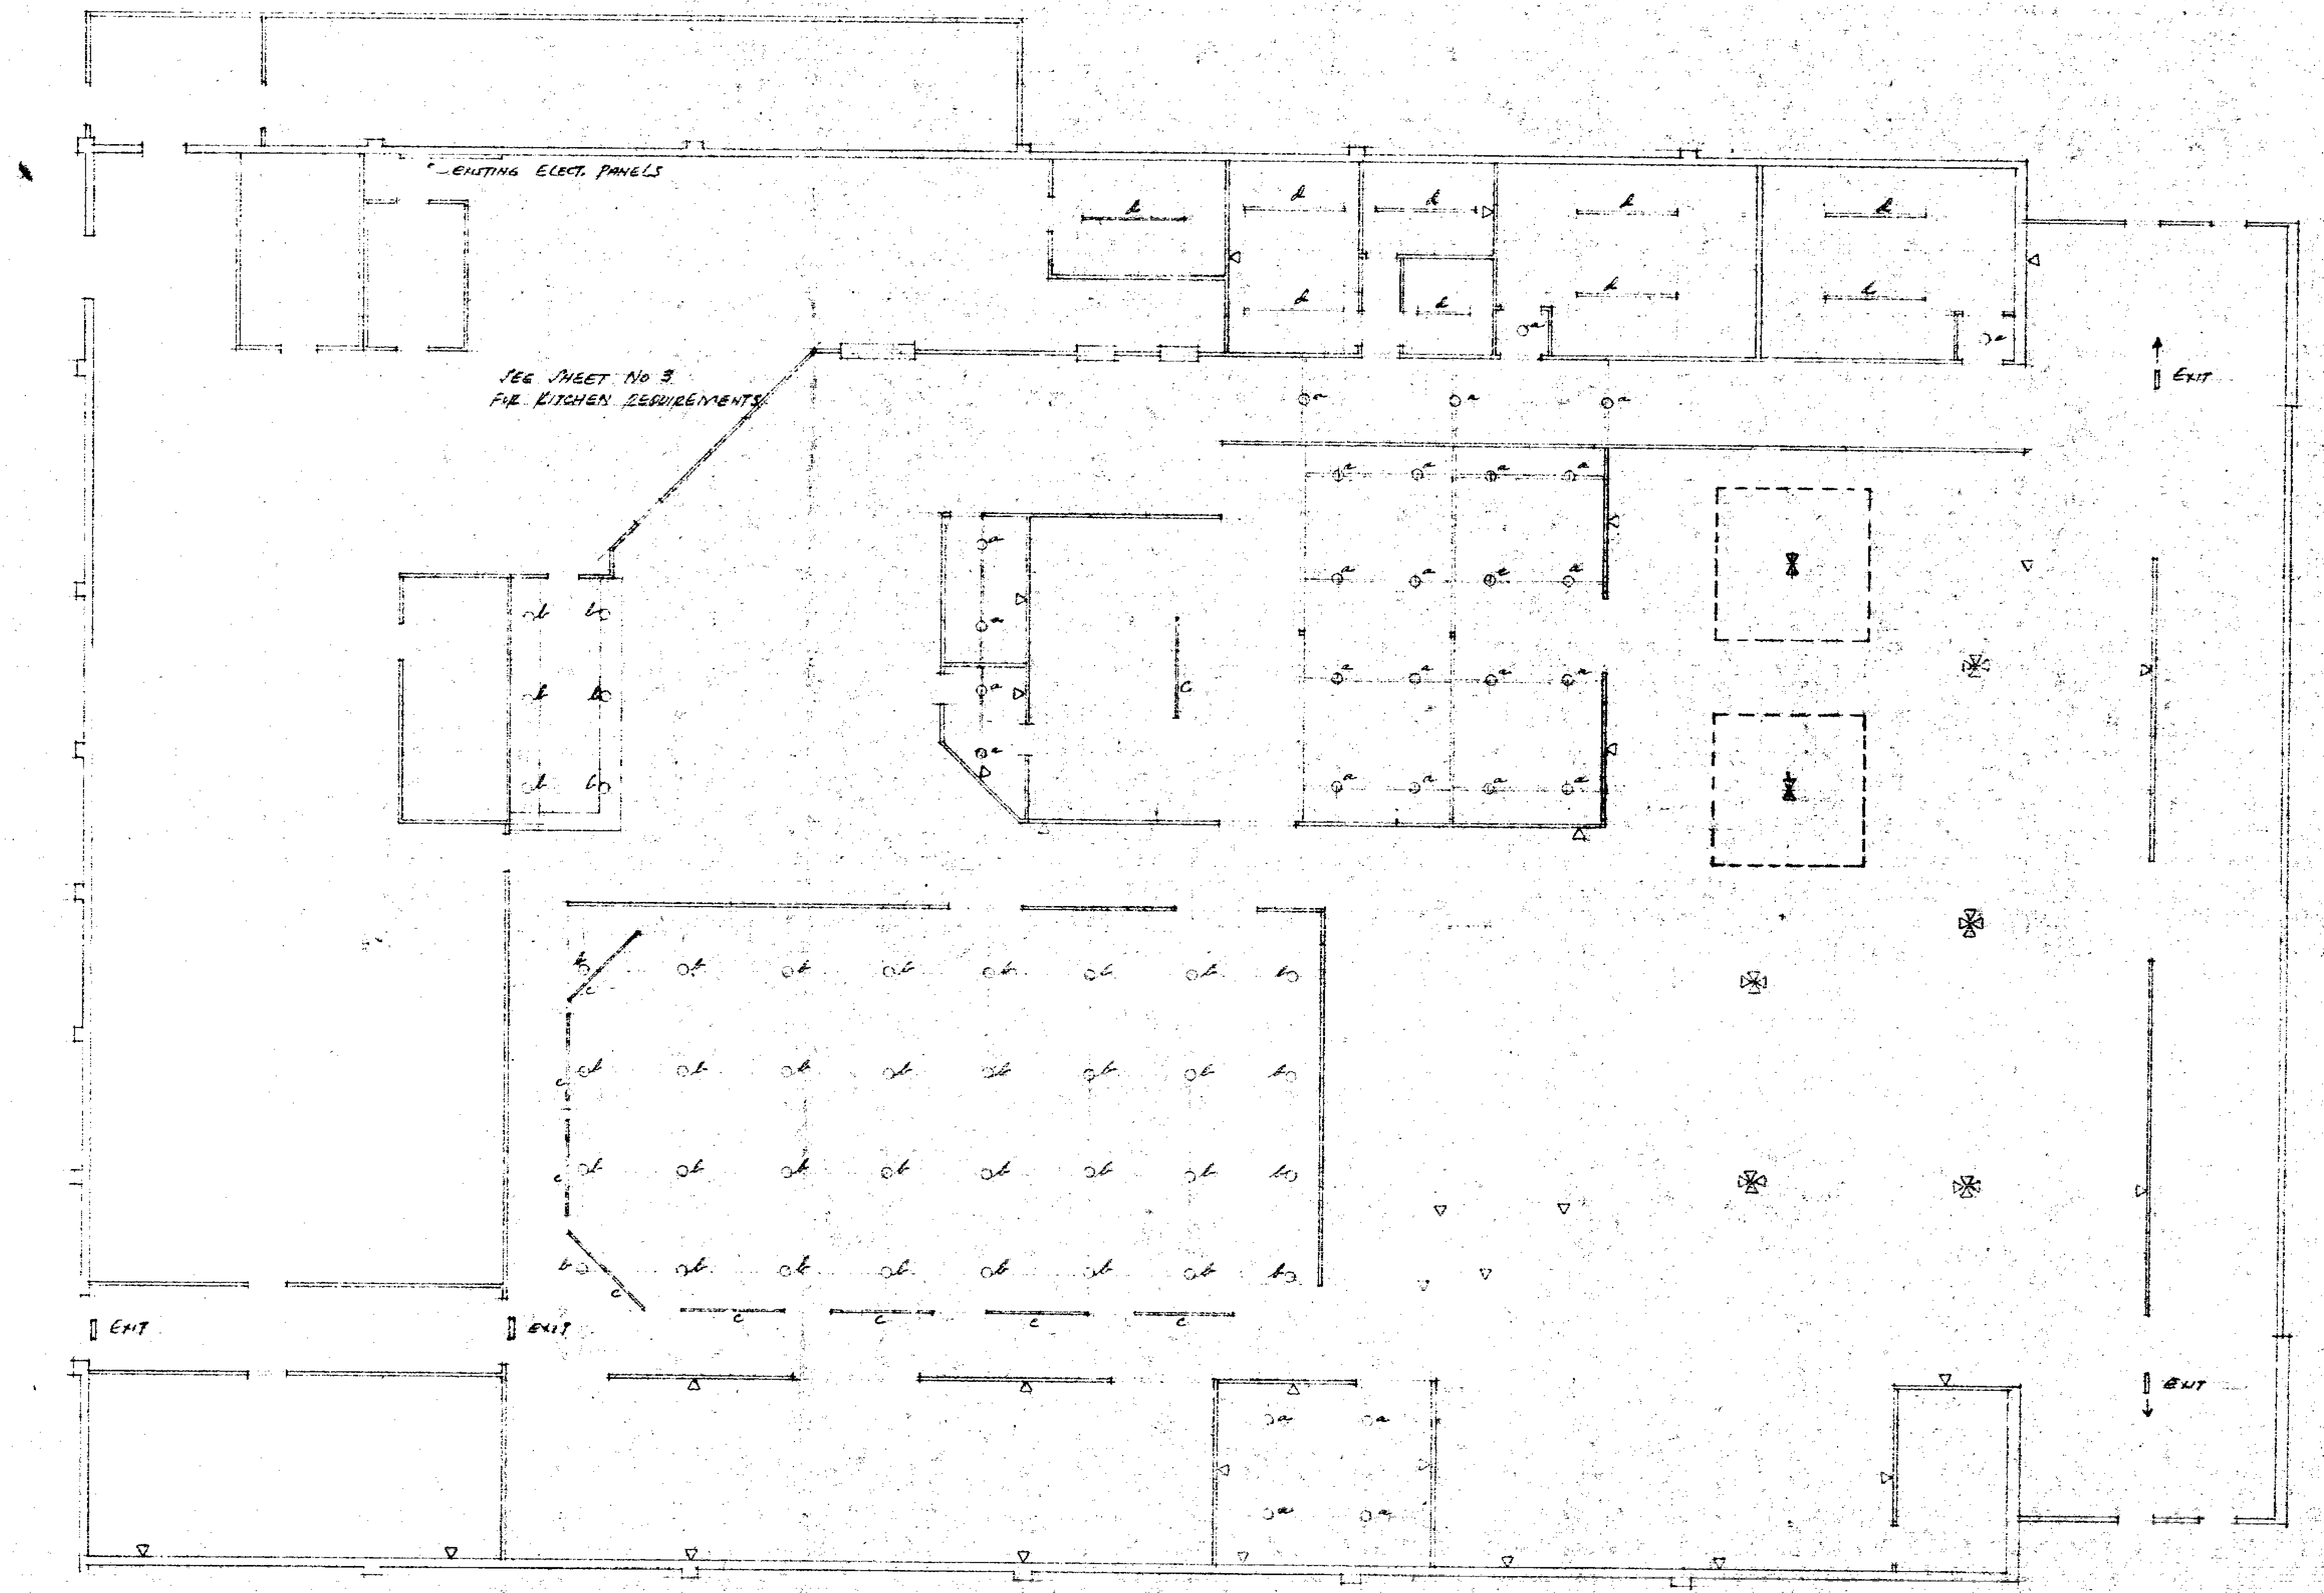

REFLECTED CEILING PLAN
1/8" = 1'-0"

FIXTURE SCHEDULE

a. HALO H-2313 SURFACE MOUNT CLYINDER, 75 WATT R-30 LAMPS.
b. SAME AS a EXCEPT TO BE HUNG AT 12'-0" WITH TUBULAR SUPPORT HANGERS.
c. LIGHTOLIER TWO CIRCUIT TRACK LIGHTS HUNG AT 12'-0", 4'-0" LONG RUN TO INDIVIDUAL SWITCHES. PROVIDE (24) LIGHTS.
d. SURFACE MOUNT (2) LIGHT FLOURESCANT FIXTURES, SWITCH TO PANEL.

▽ WHERE SHOWN PROVIDE 20 AMP 115/60/1 ϕ PLUG OUTLET. IN WALLS AT +12". IN FLOOR PROVIDE FLUSH SCREW COVER.

PROVIDE EXIT + EMERGENCY LIGHTS AS REQUIRED BY FIRE MARSHALL

EXITING LIGHTING TO REMAIN FOR ALL AREAS. RELAMP AS DIRECTED BY OWNER.

15

12341

PIZZA TIME THEATRE
SAN JOSE, CA.

BY
DESIGN SERVICES
MENLO PARK, CA.

SHEET No

ER1